


1 LOCATION OF WATER WELL: County: Ford	Fraction NW SW SW	Section Number 25	Township Number 26S	Range Number 25W EW
---	--------------------------	--------------------------	----------------------------	----------------------------

Distance and direction from nearest town or city street address of well if located within city?
304 E. Wyatt Earp Blvd., Dodge City, Ks

2 WATER WELL OWNER: Former Fina #9473

RR #, St. Address, Box #: **c/o Arcadis 5100 E. Skelly Drive #1000**
 City, State, ZIP Code : **Tulsa, OK 74135**

Board of Agriculture, Division of Water Resources
 Application Number:

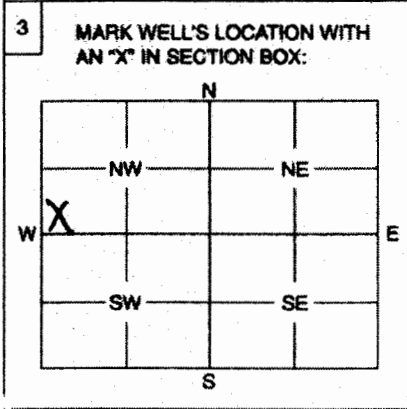

4 DEPTH OF WELL **49** ft.

WELL'S STATIC WATER LEVEL **dry** ft.

WELL WAS USED AS:

1 Domestic	5 Public Water Supply	9 Dewatering
2 Irrigation	6 Oil Field Water Supply	10 Monitoring Well
3 Feedlot	7 Domestic (Lawn & Garden)	11 Injection Well
4 Industrial	8 Air Conditioning	12 Other

Was a chemical / bacteriological sample submitted to Department? Yes No **X**

If yes, mo/day/yr sample was submitted

Water Well Disinfected: Yes No **X**

5 TYPE OF BLANK CASING USED:

1 Steel	3 RMP (SR)	5 Wrought	7 Fiberglass	9 Other (Specify below)
2 PVC	4 ABS	6 Asbestos-Cement	8 Concrete Tile	

Blank casing diameter **3 1/2** in. Was casing pulled? Yes No **X** If yes, how much

Casing height above or below land surface in.

6 GROUT PLUG MATERIAL: 1 Neat cement **2** Cement grout **3** Bentonite 4 Other

GROUT Plug Intervals: From **3** **49** ft. to **3** ft. From **3** ft. to **0** ft. From to ft.

What is the nearest source of possible contamination:

1 Septic tank	6 Seepage pit	11 Fuel storage
2 Sewer lines	7 Pit privy	12 Fertilizer storage
3 Watertight sewer lines	8 Sewage lagoon	13 Insecticide storage
4 Lateral lines	9 Feedyard	14 Abandoned water well
5 Cess pool	10 Livestock pens	15 Oil well/Gas well

16 Other (specify below) **cont. site**

Direction from well? How many feet?

FROM	TO	PLUGGING MATERIALS
49	3	Bentonite
3	0	Concrete Cap

7 CONTRACTOR'S OF LANDOWNER'S CERTIFICATION: This water well was plugged under my jurisdiction and was completed on (mo/day/year) **06/26/07** and this record is true to the best of my knowledge and belief. Kansas Water Well Contractor's License No. **585** This Water Well Record was completed on (mo/day/year) **07/24/07** under the business name of **Associated Environmental, Inc.**

by (signature) **B. Johnson**

INSTRUCTIONS: Use typewriter or ball point pen. Please press firmly and print clearly. Please fill in blanks, underline or circle the correct answers. Send top three copies to Kansas Department of Health and Environment, Bureau of Water, Geology Section, 1000 SW Jackson St., Ste. 420, Topeka, Kansas 66612-1367. Telephone: 785/296-5522. Send one to Water Well Owner and retain one for your records.