


WATER WELL RECORD Form WWC-5 KSA 82a-1212

1 LOCATION OF WATER WELL: County: Ford Fraction: SW 1/4 SE 1/4 SE 1/4 Section Number: 25 Township Number: T 26 S Range Number: R 25 E 1

Distance and direction from nearest town or city street address of well if located within city?
In town Dodge City, KS.

2 WATER WELL OWNER: Burlington Northern Santa Fe Railway
 RR#, St. Address, Box #: 804 E. Trail Rd. Board of Agriculture, Division of Water Resources
 City, State, ZIP Code: Dodge City, Ks. Application Number:

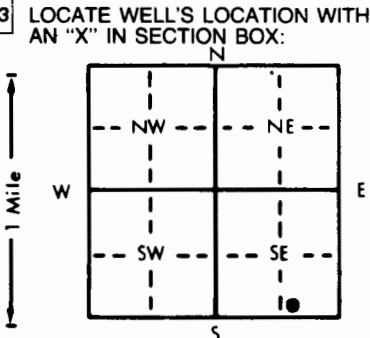

4 DEPTH OF COMPLETED WELL: 35' ft. ELEVATION:
 Depth(s) Groundwater Encountered: 1. 31' ft. 2. _____ ft. 3. _____ ft.
 WELL'S STATIC WATER LEVEL: 31' ft. below land surface measured on mo/day/yr 10-2-98
 Pump test data: Well water was _____ ft. after _____ hours pumping _____ gpm
 Est. Yield _____ gpm; Well water was _____ ft. after _____ hours pumping _____ gpm
 Bore Hole Diameter: 8 1/2" in. to 35' ft., and _____ in. to _____ ft.
 WELL WATER TO BE USED AS:
 5 Public water supply 8 Air conditioning 11 Injection well
 1 Domestic 3 Feedlot 6 Oil field water supply 9 Dewatering 12 Other (Specify below)
 2 Irrigation 4 Industrial 7 Lawn and garden only 10 Monitoring well
 Was a chemical/bacteriological sample submitted to Department? Yes _____ No X; If yes, mo/day/yr sample was submitted _____
 Water Well Disinfected? Yes _____ No X

5 TYPE OF BLANK CASING USED:
 1 Steel 3 RMP (SR) 5 Wrought iron 8 Concrete tile CASING JOINTS: Glued _____ Clamped _____
2 PVC 4 ABS 6 Asbestos-Cement 9 Other (specify below) Welded _____
 7 Fiberglass _____ Threaded X
 Blank casing diameter 2.375 in. to 20' ft., Dia _____ in. to _____ ft., Dia _____ in. to _____ ft.
 Casing height above land surface 2 in., weight _____ lbs./ft. Wall thickness or gauge No. SCF 40
 TYPE OF SCREEN OR PERFORATION MATERIAL:
 1 Steel 3 Stainless steel 5 Fiberglass 8 RMP (SR) 10 Asbestos-cement
 2 Brass 4 Galvanized steel 6 Concrete tile 9 ABS 11 Other (specify) _____
 12 None used (open hole)
 SCREEN OR PERFORATION OPENINGS ARE:
 1 Continuous slot 3 Mill slot 5 Gauzed wrapped 8 Saw cut 11 None (open hole)
 2 Louvered shutter 4 Key punched 6 Wire wrapped 9 Drilled holes
 7 Torch cut 10 Other (specify) _____
 SCREEN-PERFORATED INTERVALS: From 35' ft. to 20' ft., From _____ ft. to _____ ft.
 From _____ ft. to _____ ft., From _____ ft. to _____ ft.
 GRAVEL PACK INTERVALS: From 35' ft. to 18' ft., From _____ ft. to _____ ft.
 From _____ ft. to _____ ft., From _____ ft. to _____ ft.

6 GROUT MATERIAL: 1 Neat cement 2 Cement grout 3 Bentonite 4 Other _____
 Grout Intervals: From 18' ft. to 3' ft., From 3' ft. to 0' ft., From _____ ft. to _____ ft.
 What is the nearest source of possible contamination:
 1 Septic tank 4 Lateral lines 7 Pit privy 10 Livestock pens 14 Abandoned water well
 2 Sewer lines 5 Cess pool 8 Sewage lagoon 11 Fuel storage 15 Oil well/Gas well
 3 Watertight sewer lines 6 Seepage pit 9 Feedyard 12 Fertilizer storage 16 Other (specify below)
 13 Insecticide storage
 Direction from well? West How many feet? 700'

FROM	TO	LITHOLOGIC LOG	FROM	TO	PLUGGING INTERVALS
0	5	Fill material, brick, concr. rubble, RR ballast.			
5	9	White chalky substance, friable, when dry, sticky upon wet.			
9	20	brn clay, firm, slightly moist.			
20	24	Clayey silt, brn, moist, slightly firm.			
24	28	Brn silty clay, moist, sl firm.			
28	33	Sm-med sand, sub rounded.			
33	35	sand, coarse grained, poorly sorted, sub rounded.			

7 CONTRACTOR'S OR LANDOWNER'S CERTIFICATION: This water well was (1) constructed, (2) reconstructed, or (3) plugged under my jurisdiction and was completed on (mo/day/year) 9-23-98 and this record is true to the best of my knowledge and belief. Kansas Water Well Contractor's License No. 539 This Water Well Record was completed on (mo/day/yr) 10-2-98 under the business name of Environmental Drilling by (signature) James Baker

OFFICE USE ONLY
T
R
EW
SEC