


**1 LOCATION OF WATER WELL:** Fraction NE ¼ SW ¼ SW ¼ Section Number 25 Township Number 26 Range Number 25 (W)  
 County: Ford

Distance and direction from nearest town or city street address of well if located within city?  
406 E. Wyatt Earp, Dodge City, KS

**2 WATER WELL OWNER:**  
**The Musket Corporation – Michael Key**  
 RR#, St. Address, Box #: PO BOX 26210  
 City, State, ZIP Code: Oklahoma City, OK 73126

**Global Positioning System** (decimal degrees, min. of 4 digits)  
 Latitude: \_\_\_\_\_  
 Longitude: \_\_\_\_\_  
 Elevation: \_\_\_\_\_  
 Datum: \_\_\_\_\_  
 Data Collection Method: \_\_\_\_\_

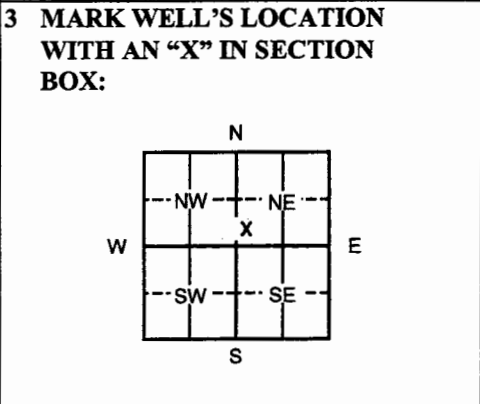

**4 DEPTH OF WELL** 39.60 ft.  
 WELL'S STATIC WATER LEVEL 39.14 ft.  
 WELL WAS USED AS:  
 1 Domestic      5 Public Water Supply      9 Dewatering  
 2 Irrigation    6 Oil Field Water Supply      10 Monitoring  
 3 Feedlot       7 Domestic (Lawn & Garden)   11 Injection Well  
 4 Industrial    8 Air Conditioning              12 Other Vapor Extracting

Was a chemical/bacteriological sample submitted to Department? Yes \_\_\_ No X

**5 TYPE OF BLANK CASING USED:**  
 1 Steel      3 RMP (SR)      5 Wrought      7 Fiberglass      9 Other (Specify below) \_\_\_\_\_  
 (2 PVC)    4 ABS            6 Asbestos-Cement   8 Concrete Tile

Blank casing diameter 4 in. Was casing pulled? Yes X No \_\_\_ If yes, how much 3 Feet  
 Casing height above or below land surface \_\_\_\_\_ in.

**6 GROUT PLUG MATERIAL:** 1 Neat cement    2 Cement grout    **3 Bentonite**    4 Other \_\_\_\_\_

Grout Plug Intervals: From 3 ft. to 39.60 ft., From \_\_\_\_\_ ft. to \_\_\_\_\_ ft., From \_\_\_\_\_ to \_\_\_\_\_ ft.

What is the nearest source of possible contamination:  
 1 Septic tank      6 Seepage pit      11 Fuel Storage      **16 Other (specify below)**  
 2 Sewer lines     7 Pit privy        12 Fertilizer storage      Lust Site  
 3 Watertight sewer lines 8 Sewage lagoon   13 Insecticide storage  
 4 Lateral lines    9 Feedyard        14 Abandoned water well   Direction from well?  
 5 Cess pool        10 Livestock pens 15 Oil well/Gas well      How many feet?

FROM	TO	PLUGGING MATERIALS	FROM	TO	PLUGGING MATERIALS
0	0.5	Concrete			
0.5	3	Soil			
3	39.60	Bentonite Grout			
					VEW10

**7 CONTRACTOR'S OR LANDOWNER'S CERTIFICATION:** This water well was plugged under my jurisdiction and was completed on (mo/day/year) 03/11/2008 and this record is true to the best of my knowledge and belief. Kansas Water Well Contractor's License No. 594. This Water Well Record was completed on (mo/day/year) 04/02/2008 under the business name of Coranco Great Plains, Inc. by (signature)

**INSTRUCTIONS:** Please fill in blanks or circle the correct answers. Send top three copies to Kansas Department of Health and Environment, Bureau of Water, Geology Section, 1000 SW Jackson St., Ste. 420, Topeka, Kansas 66612-1367. Telephone: 785/296-5522. Send one to Water Well Owner and retain one for your records. Visit us at <http://www.kdheks.gov/waterwell>.