

CORRECTION(S) TO WATER WELL RECORD (WWC-5)  
(to rectify lacking or incorrect information)

County: Ford

Location listed as:

Location changed to:

Section-Township-Range: None Given

22-26 S-25 W

Fraction (  $\frac{1}{4}$   $\frac{1}{4}$   $\frac{1}{4}$ ): \_\_\_\_\_

SE SE NE

Other changes: Initial statements: \_\_\_\_\_

Changed to: \_\_\_\_\_

Comments: Well was in vacant lot on W. side of N. 14<sup>th</sup> Ave.  
in the 2200 block, between a church on the N., small mall on the S.

verification method: Phone call to well contractor, city street map,  
and mapping tool & aerial photos on KGS website.


initials: ORA date: 9/18/2008

1 LOCATION OF WATER WELL: Fraction Section Number Township Number Range Number  
 COUNTY: FORD 1/4 1/4 1/4 T S R

Distance and direction from nearest town or city street address of well if located within city?  
 NORTH 14TH STREET DODGE CITY, KS 67801-

2 WATER WELL OWNER: WESTERN STATE BANK  
 RR#, St. Address, Box #: PO BOX 1317 Board of Agriculture, Division of Water Resources  
 City, State, ZIP code: DODGE CITY, KS 67801- Application Number:

3 LOCATE WELL'S LOCATION WITH AN "X" IN SECTION BOX:

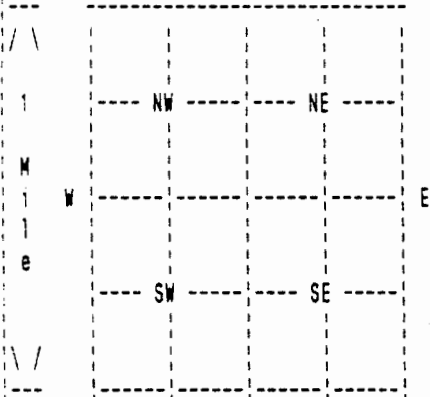

4 DEPTH OF COMPLETED WELL 240 ELEVATION: 0  
 Depth(s) Groundwater Encountered 1. 0 ft. 2. 0 ft. 3. 0 ft.

WELL'S STATIC WATER LEVEL 153 ft. below land surface measured on mo/day/yr 04/14/08  
 Pump testdata: Well water was 0 ft. after 0 hours pumping 0 gpm

Estimated Yield 0 gpm: Well water was 0 ft. after 0 hours pumping 0 gpm

Bore Hole Diameter in. to 0 ft., and in. to 0 ft.

WELL WATER WAS: DOMESTIC

Was a chemical/bacteriological sample submitted to department? No ;  
 If yes, mo/day/yr sample was submitted Water well disinfected? Yes

5 TYPE OF BLANK CASING USED: STEEL CASING JOINTS:  
 Blank casing diameter 4 in. to 240 ft., Dia in. to 0 ft., Dia in. to 0 ft..  
 Casing height above land surface 0 in., weight 0 lbs/ft. Wall thickness or gauge No.  
 TYPE OF SCREEN OR PERFORATION MATERIAL:  
 SCREEN OR PERFORATION OPENINGS ARE:

SCREEN PERFORATED INTERVALS: From 0 ft. to 0 ft., From 0 ft. to 0 ft.  
 From 0 ft. to 0 ft., From 0 ft. to 0 ft.  
 GRAVEL PACK INTERVALS: From 0 ft. to 0 ft., From 0 ft. to 0 ft.  
 From 0 ft. to 0 ft., From 0 ft. to 0 ft.

6 GROUT MATERIAL BENTONITE  
 Grout Intervals: From 0 ft. to 0 ft., From 0 ft. to 0 ft., From 0 ft. to 0 ft.  
 What is the nearest source of possible contamination: NONE  
 Direction from well? How many feet? 0

FROM	TO	LITHOLOGIC LOG	FROM	TO	PLUGGING INTERVALS
			0	60	BENTONITE
			60	102	FILL SAND
			102	160	BENTONITE GROUT
			160	240	FILL SAND
			0	0	
			0	0	
			0	0	
			0	0	
			0	0	
			0	0	

7 CONTRACTOR'S OR LANDOWNER'S CERTIFICATION: This water well was Plugged under my jurisdiction and was completed on (mo/day/year) and this record is true to the best of my knowledge and belief. Kansas Water Well Contractor's License No. 179 This Water Well Record was completed on (mo/day/yr) 04/24/08 under the business name of JOE'S WELL SERVICE, INC. by (signature) *Julia Cook*