

CORRECTION(S) TO WATER WELL RECORD (WWC-5)
(to rectify lacking or incorrect information)

County: Ford

Location listed as:

Section-Township-Range: 27-26-25W

Fraction (1/4 1/4 1/4): NW SE SW

Location changed to:

26-265-25W

NW SE SW

Other changes: Initial statements: _____

Changed to: _____

Comments: _____

verification method: written description, city street map, and mapping tool on KGS website.


initials: DRF date: 3/7/2010

submitted by: Kansas Geological Survey, Data Resources Library, 1930 Constant Ave., Lawrence, KS 66047-3726
to: Kansas Dept of Health & Environment, Bureau of Water, 1000 SW Jackson, Suite 420, Topeka, KS 66612-1367.

| | | | | | |
|---------|-------------------------|-------------------|----------------|-----------------|--------------|
| 1 | LOCATION OF WATER WELL: | Fraction | Section Number | Township Number | Range Number |
| County: | Ford | N&E SE 1/4 SW 1/4 | 27 | 26 | 25W |

Distance and direction from nearest town or city street address of well if located within city?
 Dodge City - 10th Ave. north of Wyatt Earp Blvd.

2 WATER WELL OWNER: MUSKET CORP.
 RR #, St. Address, Box #: PO Box 26210
 City, State, ZIP Code: Oklahoma City, OK 73126
 Board of Agriculture, Division of Water Resources
 Application Number:

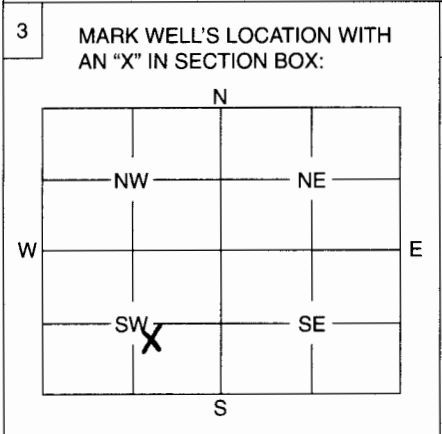

4 DEPTH OF WELL 55.00 ft.
 WELL'S STATIC WATER LEVEL 48.23 ft.
 WELL WAS USED AS:
 1 Domestic 5 Public Water Supply 9 Dewatering
 2 Irrigation 6 Oil Field Water Supply 10 Monitoring Well
 3 Feedlot 7 Domestic (Lawn & Garden) 11 Injection Well
 4 Industrial 8 Air Conditioning 12 Other

Was a chemical / bacteriological sample submitted to Department? Yes No
 If yes, mo/day/yr sample was submitted 3/7/08

Water Well Disinfected: Yes No

5 TYPE OF BLANK CASING USED:
 1 Steel 3 RMP (SR) 5 Wrought 7 Fiberglass 9 Other (Specify below)
 2 PVC 4 ABS 6 Asbestos-Cement 8 Concrete Tile

Blank casing diameter 2 in. Was casing pulled? Yes No If yes, how much 2'

Casing height above or below land surface in.

6 GROUT PLUG MATERIAL: 1 Neat cement 2 Cement grout 3 Bentonite 4 Other

Grout Plug Intervals: From 55 ft. to 2 ft., From ft. to ft., From to ft.

What is the nearest source of possible contamination:
 1 Septic tank 6 Seepage pit 11 Fuel storage 16 Other (specify below)
 2 Sewer lines 7 Pit privy 12 Fertilizer storage
 3 Watertight sewer lines 8 Sewage lagoon 13 Insecticide storage
 4 Lateral lines 9 Feedyard 14 Abandoned water well
 5 Cess pool 10 Livestock pens 15 Oil well/Gas well

Direction from well? south How many feet? 200'

| FROM | TO | PLUGGING MATERIALS |
|------|----|--------------------|
| 55 | 2 | Bentonite Grout |
| 2 | 0 | Native Soil |
| | | |
| | | |
| | | |
| | | |

7 CONTRACTOR'S OF LANDOWNER'S CERTIFICATION: This water well was plugged under my jurisdiction and was completed on (mo/day/year) 9/5/08 7/29/08 and this record is true to the best of my knowledge and belief. Kansas Water Well Contractor's License No. 594 This Water Well Record was completed on (mo/day/year) 8/20/2003 under the business name of Ceranco Great Plains
 by (signature) [Signature]

INSTRUCTIONS: Use typewriter or ball point pen. Please press firmly and print clearly. Please fill in blanks, underline or circle the correct answers. Send top three copies to Kansas Department of Health and Environment, Bureau of Water, Geology Section, 1000 SW Jackson St., Ste. 420, Topeka, Kansas 66612-1367. Telephone: 785/296-5522. Send one to Water Well Owner and retain one for your records.