

Correct
MW-13

WATER WELL PLUGGING RECORD

Form WWC-5P

KSA 82a-1212

ID No.


MW-13

1 LOCATION OF WATER WELL: County: Ford	Fraction NW 1/4 SE 1/4 SW 1/4	Section Number 25	Township Number 26S	Range Number 25W
---	----------------------------------	----------------------	------------------------	---------------------

Distance and direction from nearest town or city street address of well if located within city?
510 E. Wyatt Earp, Dodge City, KS

2 WATER WELL OWNER: FFP Operating Partners RR#, St. Address, Box # 2801 Glenda Ave City, State, ZIP Code Fort Worth, TX 76117	Board of Agriculture, Division of Water Resources Application Number:
---	--

3 MARK WELL'S LOCATION WITH AN "X" IN SECTION BOX:

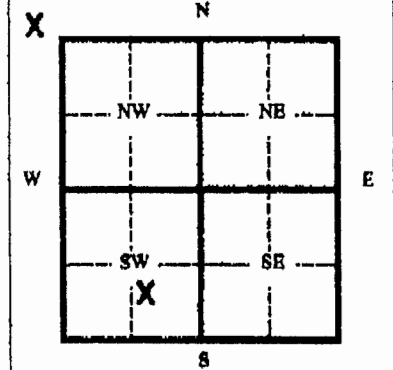

4 DEPTH OF WELL 53.2 ft.

WELL'S STATIC WATER LEVEL _____ ft.

WELL WAS USED AS:

1 Domestic	5 Public Water Supply	9 Dewatering
2 Irrigation	6 Oil Field Water Supply	10 Monitoring Well
3 Feedlot	7 Lawn and Garden (domestic)	11 Injection Well
4 Industrial	8 Air Conditioning	12 Other _____

Was a chemical/bacteriological sample submitted to Department? Yes _____ No _____
 If yes, mo/day/yr sample was submitted _____
 Water Well Disinfected: Yes _____ No _____

5 TYPE OF BLANK CASING USED:

1 Steel	3 RMP (SR)	5 Wrought	7 Fiberglass	9 Other (specify below)
2 PVC	4 ABC	6 Asbestos-Cement	8 Concrete Tile	

Blank casing diameter 2 in. Was casing pulled? Yes No _____ If yes, how much 3 ft.
 Casing height above or below land surface -36 in.

6 GROUT PLUG MATERIAL: 1 Neat cement 2 Cement grout 3 Bentonite 4 Other _____

Grout Plug Intervals From 0 ft. to 53.2 ft. From _____ ft. to _____ ft. From _____ ft. to _____ ft.

What is the nearest source of possible contamination:

1 Septic tank	6 Seepage pit	11 Fuel storage	16 Other (specify below)
2 Sewer lines	7 Pit privy	12 Fertilizer storage	
3 Watertight sewer lines	8 Sewage lagoon	13 Insecticide storage	
4 Lateral lines	9 Feedyard	14 Abandoned water well	
5 Cess Pool	10 Livestock pens	15 Oil well/ Gas well	

Direction from well? _____ How many feet? _____

FROM	TO	CODE	PLUGGING MATERIALS
0	53.2		Bentonite

RECEIVED
JAN 08 2009
BUREAU OF WATER

7 CONTRACTOR'S OR LANDOWNER'S CERTIFICATION: This water well was plugged under my jurisdiction and was completed on (mo/day/yr) 8/1/07 and this record is true to the best of my knowledge and belief. Kansas Water Well Contractor's License No. 554 This Water Well Record was completed on (mo/day/yr) 8/2/07 under the business name of Bluestem Environmental Engineering, Inc. by (signature) *Nick Holt*

INSTRUCTIONS: Please fill in blanks and circle the correct answers. Send three copies to Kansas Department of Health and Environment, Bureau of Water, 1000 S W Jackson St., Ste. 420, Topeka, Kansas 66620-0001. Telephone: 785-298-3565. Send one to Water Well Owner and retain one for your records.