WATER WELL PLUGGING RECORD Form WWC-5P KSA 82a-1212 ID NO.

1 LOCATION OF WATER WELL: County: Ford | Fraction: ¼ SW ¼ SE ¼ SW ¼ | Section Number: 26 | Township Number: T 26 S | Range Number: 25 ☐ E ☑ W

Street/Rural Address of Well Location; if unknown, distance & direction from nearest town or intersection: If at owner's address, check here ☐

710 West Trail Street and 800 West Trail Street, Dodge City, KS

Global Positioning Systems (GPS) information:
Latitude: _____ (in decimal degrees)
Longitude: _____ (in decimal degrees)
Elevation: _____
Datum: ☐ WGS84, ☐ NAD83, ☐ NAD27
Collection Method:
☐ GPS unit (Make/Model: _____)
☐ Digital Map/Photo, ☐ Topographic Map, ☐ Land Survey
Est. Accuracy: ☐ < 3 m, ☐ 3-5 m, ☐ 5-15 m, ☐ > 15 m

2 WATER WELL OWNER: Dodge City Cooperative
RR#, St. Address, Box #: 800 West Trail Street
City, State ZIP Code: Dodge City, KS 67563

3 MARK WELL'S LOCATION WITH AN "X" IN SECTION BOX:

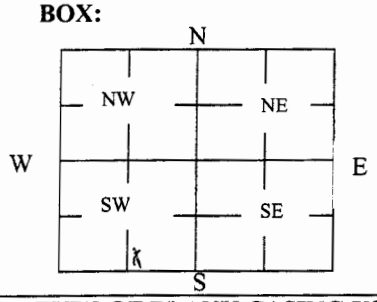

4 DEPTH OF WELL 31.60 ft.
WELL'S STATIC WATER LEVE DRY ft
WELL WAS USED AS:

☐ Domestic	☐ Public Water Supply	☐ Dewatering	
☐ Irrigation	☐ Oil Field Water Supply	☐ Monitoring	
☐ Feedlot	☐ Domestic (Lawn & Garden)	☐ Injection Well	
☐ Industrial	☐ Air Conditioning	☑ Other Air Sparge	

Was a chemical/bacteriological sample submitted to Department? Yes ☐ No ☑

5 TYPE OF BLANK CASING USED:

☐ Steel ☑ PVC ☐ RMP (SR) ☐ ABS ☐ Wrought ☐ Asbestos-Cement ☐ Fiberglass ☐ Concrete Tile ☐ Other (Specify below) _____

Blank casing diameter 1.25 in. Was casing pulled? Yes ☑ No ☐ If yes, how much 3 Feet
Casing height above or below land surface _____ in.

6 GROUT PLUG MATERIAL: ☐ Neat cement ☐ Cement grout ☑ Bentonite ☐ Other _____

Grout Plug Intervals: From 3 ft. to 31.60 ft., From _____ ft. to _____ ft., From _____ to _____ ft.

What is the nearest source of possible contamination:

☐ Septic tank	☐ Seepage pit	☐ Fuel Storage	☑ Other (specify below) Lust Site
☐ Sewer lines	☐ Pit privy	☐ Fertilizer storage	
☐ Watertight sewer lines	☐ Sewage lagoon	☐ Insecticide storage	
☐ Lateral lines	☐ Feedyard	☐ Abandoned water well	Direction from well? _____
☐ Cess pool	☐ Livestock pens	☐ Oil well/Gas well	How many feet? _____

FROM	TO	PLUGGING MATERIALS	FROM	TO	PLUGGING MATERIALS
0	1	Concrete			
1	3	Native soils			
3	31.60	Bentonite Grout			AS-9C

7 CONTRACTOR'S OR LANDOWNER'S CERTIFICATION: This water well was plugged under my jurisdiction and was completed on (mo/day/year) 04/21/2009 and this record is true to the best of my knowledge and belief. Kansas Water Well Contractor's License No. 594. This Water Well Record was completed on (mo/day/year) 05/21/2009 under the business name of Coranco Great Plains, Inc. by (signature) _____

INSTRUCTIONS: Use typewriter or ballpoint pen. Please press firmly and print clearly. Please fill in blanks, underline or circle the correct answers. Send top three copies to Kansas Department of Health and Environment, Bureau of Water, Geology Section, 1000 SW Jackson St., Ste. 420, Topeka, Kansas 66612-1367. Telephone: 785/296-5524. Send one to Water Well Owner and retain one for your records. Visit us at http://www.kdheks.gov/waterwell/index.html.

Check one: ☐ White Copy ☐ Blue Copy ☐ Pink Copy