


WATER WELL PLUGGING RECORD Form WWC-5P KSA 82a-1212 ID NO.

1 LOCATION OF WATER WELL: County: <b>Ford</b>	Fraction <b>SW ¼ SW ¼ SW ¼</b>	Section Number <b>13</b>	Township Number <b>26S</b>	Range Number <b>25</b>
--	-----------------------------------	-----------------------------	-------------------------------	---------------------------

Distance and direction from nearest town or city street address of well if located within city?  
**100 Frontview, Dodge City**

2 WATER WELL OWNER: <b>Fas Stop (U-Pump-It)</b> RR#, St. Address, Box #: <b>301 S. 2<sup>nd</sup></b> City, State, ZIP Code: <b>Dodge City, KS 67801</b>	Global Positioning System (decimal degrees, min. of 4 digits) Latitude: _____ Longitude: _____ Elevation: _____ Datum: _____ Data Collection Method: _____
--	---

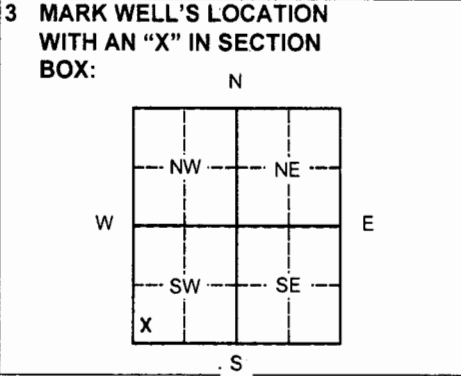

4 DEPTH OF WELL <b>135.20</b> ft. WELL'S STATIC WATER LEVEL <b>132.50</b> ft. WELL WAS USED AS: 1 Domestic      5 Public Water Supply      9 Dewatering 2 Irrigation     6 Oil Field Water Supply     10 Monitoring 3 Feedlot        7 Domestic (Lawn & Garden) 11 Injection Well 4 Industrial     8 Air Conditioning            12 <b>Other</b> <b>Recovery Well</b>
---

Was a chemical/bacteriological sample submitted to Department? Yes \_\_\_ No X

5 TYPE OF BLANK CASING USED: 1 Steel      3 RMP (SR)      5 Wrought      7 Fiberglass      9 Other (Specify below) 2 <b>PVC</b> 4 ABS            6 Asbestos-Cement      8 Concrete Tile
---

Blank casing diameter **6** in. Was casing pulled? Yes X No \_\_\_ If yes, how much **3** ft.  
Casing height above or **below** land surface **3** ft.

6 GROUT PLUG MATERIAL:      1 Neat cement      2 <b>Cement grout</b> 3 Bentonite      4 Other _____
---

Grout Plug Intervals: From **3** ft. to **135.2** ft., From \_\_\_\_\_ ft. to \_\_\_\_\_ ft., From \_\_\_\_\_ to \_\_\_\_\_ ft.

What is the nearest source of possible contamination:  
1 Septic tank      6 Seepage pit      11 Fuel Storage      16 Other (specify below)  
2 Sewer lines     7 Pit privy        12 Fertilizer storage  
3 Watertight sewer lines 8 Sewage lagoon      13 Insecticide storage  
4 Lateral lines    9 Feedyard        14 Abandoned water well      Direction from well?  
5 Cess pool        10 Livestock pens      15 Oil well/Gas well            How many feet?

FROM	TO	PLUGGING MATERIALS	FROM	TO	PLUGGING MATERIALS
0	3	Soil			
3	135.2	Cement			

7 CONTRACTOR'S OR LANDOWNER'S CERTIFICATION: This water well was plugged under my jurisdiction and was completed on (mo/day/year) **10/26/09** and this record is true to the best of my knowledge and belief. Kansas Water Well Contractor's License No. **531**. This Water Well Record was completed on (mo/day/year) **11/13/09** under the business name of **Geotechnical Services, Inc.** by (signature) *David King*

INSTRUCTIONS: Please fill in blanks or circle the correct answers. Send top three copies to Kansas Department of Health and Environment, Bureau of Water, Geology Section, 1000 SW Jackson St., Ste. 420, Topeka, Kansas 66612-1367. Telephone: 785/296-5522. Send one to Water Well Owner and retain one for your records. Visit us at <http://www.kdheks.gov/waterwell>.