


<b>1 LOCATION OF WATER WELL:</b>	Fraction	Section Number	Township Number	Range Number
County: <b>Ford</b>	<b>SE ¼ SE ¼ SE ¼</b>	<b>14</b>	<b>26S</b>	<b>25 W</b>

Distance and direction from nearest town or city street address of well if located within city?  
**100 Frontview, Dodge City**

<b>2 WATER WELL OWNER: Fas Stop (U-Pump-It)</b>	<b>Global Positioning System</b> (decimal degrees, min. of 4 digits)
RR#, St. Address, Box #: <b>301 S. 2<sup>nd</sup></b>	Latitude: _____
City, State, ZIP Code: <b>Dodge City, KS 67801</b>	Longitude: _____
	Elevation: _____
	Datum: _____
	Data Collection Method: _____

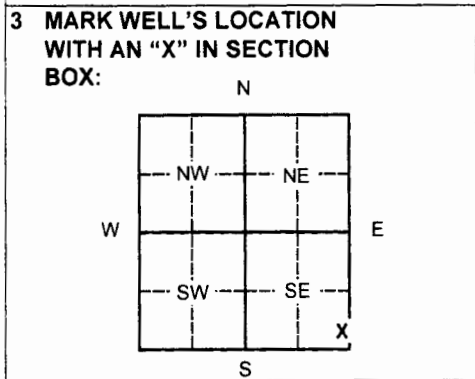

**4 DEPTH OF WELL** 122.00 ft.

WELL'S STATIC WATER LEVEL 121.90 ft

WELL WAS USED AS:

1 Domestic	5 Public Water Supply	9 Dewatering
2 Irrigation	6 Oil Field Water Supply	10 Monitoring
3 Feedlot	7 Domestic (Lawn & Garden)	11 Injection Well
4 Industrial	8 Air Conditioning	12 <input checked="" type="checkbox"/> Other Soil Vapor Extraction

Was a chemical/bacteriological sample submitted to Department? Yes \_\_\_ No

**5 TYPE OF BLANK CASING USED:**

1 Steel	3 RMP (SR)	5 Wrought	7 Fiberglass	9 Other (Specify below)
2 <input checked="" type="checkbox"/> PVC	4 ABS	6 Asbestos-Cement	8 Concrete Tile	

Blank casing diameter 2 in. Was casing pulled? Yes  No \_\_\_ If yes, how much 3 ft.

Casing height above or  below land surface 3 ft.

**6 GROUT PLUG MATERIAL:** 1 Neat cement 2 Cement grout 3  Bentonite 4 Other \_\_\_\_\_

Grout Plug Intervals: From 3 ft. to 122 ft., From \_\_\_\_\_ ft. to \_\_\_\_\_ ft., From \_\_\_\_\_ to \_\_\_\_\_ ft.

What is the nearest source of possible contamination:

1 Septic tank	6 Seepage pit	11 Fuel Storage	16 Other (specify below)
2 Sewer lines	7 Pit privy	12 Fertilizer storage	
3 Watertight sewer lines	8 Sewage lagoon	13 Insecticide storage	
4 Lateral lines	9 Feedyard	14 Abandoned water well	Direction from well?
5 Cess pool	10 Livestock pens	15 Oil well/Gas well	How many feet?

FROM	TO	PLUGGING MATERIALS	FROM	TO	PLUGGING MATERIALS
0	3	Soil			
3	122	Bentonite Chips			

**7 CONTRACTOR'S OR LANDOWNER'S CERTIFICATION:** This water well was plugged under my jurisdiction and was completed on (mo/day/year) 10/26/09 and this record is true to the best of my knowledge and belief. Kansas Water Well Contractor's License No. 531. This Water Well Record was completed on (mo/day/year) 11/13/09 under the business name of Geotechnical Services, Inc. by (signature) [Signature]

**INSTRUCTIONS:** Please fill in blanks or circle the correct answers. Send top three copies to Kansas Department of Health and Environment, Bureau of Water, Geology Section, 1000 SW Jackson St., Ste. 420, Topeka, Kansas 66612-1367. Telephone: 785/296-5522. Send one to Water Well Owner and retain one for your records. Visit us at <http://www.kdheks.gov/waterwell>.