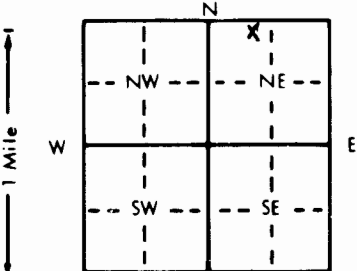


1 LOCATION OF WATER WELL: County: FORD		Fraction: NE 1/4 NW 1/4 NE 1/4		Section Number: 36		Township Number: T 26S S		Range Number: R 25 EW	
Distance and direction from nearest town or city street address of well if located within city? grassy area on SW corner of site									
2 WATER WELL OWNER: Safety Kleen									
RR#, St. Address, Box #: 600 East Trail									
City, State, ZIP Code: Dodge City, KS									
Board of Agriculture, Division of Water Resources									
Application Number:									
3 LOCATE WELL'S LOCATION WITH AN "X" IN SECTION BOX:		4 DEPTH OF COMPLETED WELL: 30 ft. ELEVATION:							
		Depth(s) Groundwater Encountered 1. _____ ft. 2. _____ ft. 3. _____ ft.							
		WELL'S STATIC WATER LEVEL _____ ft. below land surface measured on mo/day/yr							
		Pump test data: Well water was _____ ft. after _____ hours pumping _____ gpm							
		Est. Yield _____ gpm: Well water was _____ ft. after _____ hours pumping _____ gpm							
		Bore Hole Diameter: 10 in. to 30 ft., and _____ in. to _____ ft.							
		WELL WATER TO BE USED AS:							
		5 Public water supply 8 Air conditioning 11 Injection well							
		1 Domestic 3 Feedlot 6 Oil field water supply 9 Dewatering 12 Other (Specify below)							
		2 Irrigation 4 Industrial 7 Lawn and garden only 10 Monitoring well							
		Was a chemical/bacteriological sample submitted to Department? Yes _____ No _____; If yes, mo/day/yr sample was submitted _____							
		Water Well Disinfected? Yes _____ No _____							
5 TYPE OF BLANK CASING USED:									
1 Steel 3 RMP (SR) 5 Wrought iron 8 Concrete tile CASING JOINTS: Glued _____ Clamped _____									
2 PVC 4 ABS 6 Asbestos-Cement 9 Other (specify below) Welded _____									
7 Fiberglass _____ Threaded _____									
Blank casing diameter _____ in. to _____ ft., Dia _____ in. to _____ ft., Dia _____ in. to _____ ft.									
Casing height above land surface _____ in., weight _____ lbs./ft. Wall thickness or gauge No. _____									
TYPE OF SCREEN OR PERFORATION MATERIAL:									
1 Steel 3 Stainless steel 5 Fiberglass 7 PVC 10 Asbestos-cement									
2 Brass 4 Galvanized steel 6 Concrete tile 8 RMP (SR) 11 Other (specify) _____									
9 ABS 12 None used (open hole) _____									
SCREEN OR PERFORATION OPENINGS ARE:									
1 Continuous slot 3 Mill slot 5 Gauzed wrapped 8 Saw cut 11 None (open hole)									
2 Louvered shutter 4 Key punched 6 Wire wrapped 9 Drilled holes									
7 Torch cut 10 Other (specify) _____									
SCREEN-PERFORATED INTERVALS: From _____ ft. to _____ ft., From _____ ft. to _____ ft.									
From _____ ft. to _____ ft., From _____ ft. to _____ ft.									
GRAVEL PACK INTERVALS: From _____ ft. to _____ ft., From _____ ft. to _____ ft.									
From _____ ft. to _____ ft., From _____ ft. to _____ ft.									
6 GROUT MATERIAL: 1 Neat cement 2 Cement grout 3 Bentonite 4 Other _____									
Grout Intervals: From _____ ft. to _____ ft., From _____ ft. to _____ ft., From _____ ft. to _____ ft.									
What is the nearest source of possible contamination:									
1 Septic tank 4 Lateral lines 7 Pit privy 10 Livestock pens 14 Abandoned water well									
2 Sewer lines 5 Cess pool 8 Sewage lagoon 11 Fuel storage 15 Oil well/Gas well									
3 Watertight sewer lines 6 Seepage pit 9 Feedyard 12 Fertilizer storage 16 Other (specify below) _____									
13 Insecticide storage _____									
Direction from well? _____ How many feet? _____									
FROM TO LITHOLOGIC LOG FROM TO PLUGGING INTERVALS									
Neat Cement									
Casing removed - 3'									
Covered w/ soil - 3'									
7 CONTRACTOR'S OR LANDOWNER'S CERTIFICATION: This water well was (1) constructed, (2) reconstructed, or (3) plugged under my jurisdiction and was completed on (mo/day/year) _____ and this record is true to the best of my knowledge and belief. Kansas									
Water Well Contractor's License No. 581 This Water Well Record was completed on (mo/day/yr) _____ by (signature) Steven R. Mitchell									
under the business name of Layne Western Co.									
INSTRUCTIONS: Use typewriter or ball point pen. PLEASE PRESS FIRMLY and PRINT clearly. Please fill in blanks, underline or circle the correct answers. Send top three copies to Kansas Department of Health and Environment, Bureau of Water, Topeka, Kansas 66620-0001. Telephone: 913-296-5545. Send one to WATER WELL OWNER and retain one for your records.									