

WATER WELL RECORD Form WWC-5 KSA 82a-1212


1 LOCATION OF WATER WELL: Fraction Section Number Township Number Range Number
 COUNTY: FORD NW 1/4 1/4 1/4 22 T 26 S R 23

DLL
5/17/10

Distance and direction from nearest town or city street address of well if located within city?
 WRIGHT - EAST ON GARNETT TO 121 RD - 1/2 MILE SOUTH

2 WATER WELL OWNER: SHEAN FARMS
 RR#, St. Address, Box #: 10954 121 RD.
 City, State, ZIP code: WRIGHT, KS 67882-
 Board of Agriculture, Division of Water Resources
 Application Number:

3 LOCATE WELL'S LOCATION WITH AN "X" IN SECTION BOX:

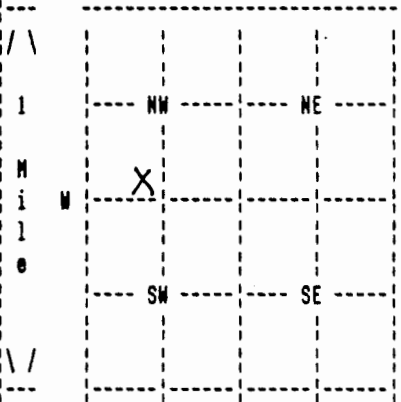

4 DEPTH OF COMPLETED WELL 385 ELEVATION: 0
 Depth(s) Groundwater Encountered 1. 0 ft. 2. 0 ft. 3. 0 ft.

WELL'S STATIC WATER LEVEL 192 ft. below land surface measured on mo/day/yr 08/19/09
 Pump test data: Well water was 0 ft. after 0 hours pumping 0 gpm

Estimated Yield 40 gpm: Well water was 0 ft. after 0 hours pumping 0 gpm

Bore Hole Diameter 10 in. to 385 ft., and in. to 0 ft.

WELL WATER TO BE USED AS: DOMESTIC

Was a chemical/bacteriological sample submitted to department? No;
 If yes, mo/day/yr sample was submitted Water well disinfected? Yes

5 TYPE OF BLANK CASING USED: CERTA LOC CASIN CASING JOINTS: CERTA-LOC
 Blank casing diameter 5 in. to 385 ft., Dia in. to 0 ft., Dia in. to 0 ft.
 Casing height above land surface 12 in., weight 200 lbs/ft. Wall thickness or gauge No. 21 17
 TYPE OF SCREEN OR PERFORATION MATERIAL: PVC
 SCREEN OR PERFORATION OPENINGS ARE: SAW CUT

SCREEN PERFORATED INTERVALS: From 320 ft. to 380 ft., From 0 ft. to 0 ft.
 From 0 ft. to 0 ft., From 0 ft. to 0 ft.
 GRAVEL PACK INTERVALS: From 30 ft. to 385 ft., From 0 ft. to 0 ft.
 From 0 ft. to 0 ft., From 0 ft. to 0 ft.

6 GROUT MATERIAL BENTONITE
 Grout Intervals: From 5 ft. to 30 ft., From 0 ft. to 0 ft., From 0 ft. to 0 ft.
 What is the nearest source of possible contamination: ABANDONED WELL
 Direction from well? SOUTH How many feet? 50

FROM	TO	LITHOLOGIC LOG	FROM	TO	PLUGGING INTERVALS
0	20	01 TOPSOIL 32 TAN CLAY			
20	40	32 TAN CLAY 21 LIMESTONE 19 LAYERS			
40	60	32 TAN CLAY 36 BLUE CLAY 16 GRAY CLAY			
60	80	36 BLUE CLAY			
80	100	36 BLUE CLAY 11 BROWN CLAY 16 GRAY CLAY			
100	140	16 GRAY CLAY 24 THINROCLAYER			
140	160	16 GRAY CLAY 24 THINROCLAYER 29 SANDSTONE			
160	180	16 GRAY CLAY 29 SANDSTONE 19 LAYERS			
180	260	16 GRAY CLAY 26 RED CLAY			
260	280	16 GRAY CLAY 26 RED CLAY 29 SANDSTONE			

7 CONTRACTOR'S OR LANDOWNER'S CERTIFICATION: This water well was Constructed under my jurisdiction and was completed on (mo/day/year) 08/21/09 and this record is true to the best of my knowledge and belief. Kansas Water Well Contractor's License No. 179 This Water Well Record was completed on (mo/day/yr) 09/30/09 under the business name of JOE'S WELL SERVICE, INC. by (signature) *Julie Creek*

(Continued)

WATER WELL RECORD Form WWC-5 KSA 82a-1212

1 LOCATION OF WATER WELL:	Fraction	Section Number	Township Number	Range Number
COUNTY: FORD	NW 1/4 1/4 1/4	22	T 26 S	R 23 E

2 WATER WELL OWNER: SHEAN FARMS
RR#, St. Address, Box # : 10954 121 RD. Board of Agriculture, Division of Water Resources
City, State, ZIP code : WRIGHT, KS 67882- Application Number: |

FROM	TO	LITHOLOGIC LOG
280	360	29 SANDSTONE
360	380	29 SANDSTONE 16 GRAY CLAY
380	400	36 BLUE CLAY 31 SHALE

7 CONTRACTOR'S OR LANDOWNER'S CERTIFICATION: This water well was Constructed under my jurisdiction and was completed on (mo/day/year) 08/21/09 and this record is true to the best of my knowledge and belief. Kansas Water Well Contractor's license No. 179 This Water Well Record was completed on (mo/day/yr) 09/30/09 under the business name of JOE'S WELL SERVICE, INC. by (signature) *Judith Creek*