


1 LOCATION OF WATER WELL:	Fraction	Section Number	Township Number	Range Number
County: <u>Ford</u>	<u>NW 1/4 NW 1/4 SE 1/4 SE</u>	<u>25</u>	<u>26</u>	<u>25</u> <span style="float: right;">E/W</span>

Distance and direction from nearest town or city street address of well if located within city?  
512 Avenue L Dodge City KS 67801

2 WATER WELL OWNER: <u>Ford County Shop</u>	Board of Agriculture, Division of Water Resources
RR #, St. Address, Box #: <u>512 Avenue L</u>	Application Number:
City, State, ZIP Code: <u>Dodge City KS 67801</u>	

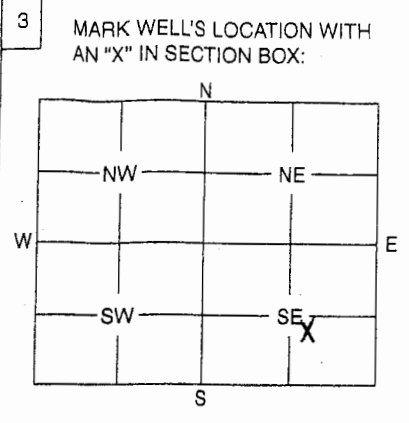

4 DEPTH OF WELL ..... 36 ..... ft.

WELL'S STATIC WATER LEVEL ..... - ..... ft.

WELL WAS USED AS:

1 Domestic	5 Public Water Supply	9 Dewatering
2 Irrigation	6 Oil Field Water Supply	10 Monitoring Well
3 Feedlot	7 Domestic (Lawn & Garden)	11 Injection Well
4 Industrial	8 Air Conditioning	12 Other ... <u>SUE</u>

Was a chemical / bacteriological sample submitted to Department? Yes ..... No X.....  
 If yes, mo/day/yr sample was submitted .....

Water Well Disinfected: Yes ..... No X.....

5 TYPE OF BLANK CASING USED:

1 Steel	3 RMP (SR)	5 Wrought	7 Fiberglass	9 Other (Specify below)
2 PVC	4 ABS	6 Asbestos-Cement	8 Concrete Tile	

Blank casing diameter ..... 4 ..... in. Was casing pulled? Yes X..... No ..... If yes, how much 3'.....  
 Casing height above or below land surface ..... 36 ..... in.

6 GROUT PLUG MATERIAL: 1 Neat cement 2 Cement grout 3 Bentonite 4 Other .....

Grout Plug Intervals: From 36 ft. to 3 ft., From ..... ft. to ..... ft., From ..... to ..... ft.

What is the nearest source of possible contamination:

1 Septic tank	6 Seepage pit	11 Fuel storage	16 Other (specify below)
2 Sewer lines	7 Pit privy	12 Fertilizer storage	
3 Watertight sewer lines	8 Sewage lagoon	13 Insecticide storage	
4 Lateral lines	9 Feedyard	14 Abandoned water well	
5 Cess pool	10 Livestock pens	15 Oil well/Gas well	

Direction from well? ..... NE ..... How many feet? ..... 30 .....

FROM	TO	PLUGGING MATERIALS
<u>36'</u>	<u>3'</u>	<u>Bentonite chips</u>
<u>3'</u>	<u>0'</u>	<u>Native material</u>

7 CONTRACTOR'S OF LANDOWNER'S CERTIFICATION: This water well was plugged under my jurisdiction and was completed on (mo/day/year) 3-17-10 ..... and this record is true to the best of my knowledge and belief. Kansas Water Well Contractor's License No. .... This Water Well Record was completed on (mo/day/year) 3-29-10 ..... under the business name of Green Field Contractors, Inc. by (signature) Jim Franzen