

WATER WELL RECORD Form WWC-5

Revised


Original Record Correction Change in Well Use

Division of Water Resources App. No.

Well ID MW #11

1 LOCATION OF WATER WELL:
 County: Ford Fraction SW 1/4 NW 1/4 SE 1/4 SE 1/4 Section Number 25 Township Number T 26 S Range Number R 25 E W

2 WELL OWNER: Last Name: First: Street or Rural Address where well is located (if unknown, distance and direction from nearest town or intersection): If at owner's address, check here:
 Business: Ford Co Government Address: 100 Gunsmoke closest intersection Ave L and Military St Dodge City, KS
 Address: City: Dodge City State: KS ZIP: 67801

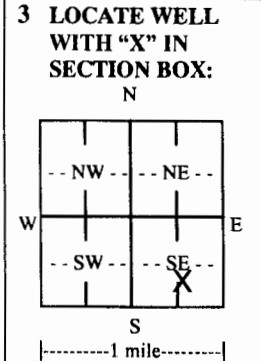

4 DEPTH OF COMPLETED WELL: 101 ft. (circled)
 Depth(s) Groundwater Encountered: 1) 89.8 ft.
 2) ft. 3) ft., or 4) Dry Well
 WELL'S STATIC WATER LEVEL: 89.8 ft.
 below land surface, measured on (mo-day-yr) 04/24/2013
 above land surface, measured on (mo-day-yr)
 Pump test data: Well water was ft. after hours pumping gpm
 Well water was ft. after hours pumping gpm
 Estimated Yield: gpm
 Bore Hole Diameter: 8 in. to 104 ft. and in. to ft.

5 Latitude: 37.75304 (decimal degrees)
Longitude: 100.00015 (decimal degrees)
 Datum: WGS 84 NAD 83 NAD 27
Source for Latitude/Longitude:
 GPS (unit make/model:)
 (WAAS enabled? Yes No)
 Land Survey Topographic Map
 Online Mapper:
6 Elevation: 2519 ft. Ground Level TOC
 Source: Land Survey GPS Topographic Map
 Other: KOLAR

7 WELL WATER TO BE USED AS:

1. <input type="checkbox"/> Domestic <input type="checkbox"/> Household <input type="checkbox"/> Lawn & Garden <input type="checkbox"/> Livestock	5. <input type="checkbox"/> Public Water Supply: well ID	10. <input type="checkbox"/> Oil Field Water Supply: lease
2. <input type="checkbox"/> Irrigation	6. <input type="checkbox"/> Dewatering: how many wells?	11. Test Hole: well ID
3. <input type="checkbox"/> Feedlot	7. <input type="checkbox"/> Aquifer Recharge: well ID	<input type="checkbox"/> Cased <input type="checkbox"/> Uncased <input type="checkbox"/> Geotechnical
4. <input type="checkbox"/> Industrial	8. <input checked="" type="checkbox"/> Monitoring: well ID MW #11	12. Geothermal: how many bores?
	9. Environmental Remediation: well ID	a) Closed Loop <input type="checkbox"/> Horizontal <input type="checkbox"/> Vertical
	<input type="checkbox"/> Air Sparge <input type="checkbox"/> Soil Vapor Extraction	b) Open Loop <input type="checkbox"/> Surface Discharge <input type="checkbox"/> Inj. of Water
	<input type="checkbox"/> Recovery <input type="checkbox"/> Injection	13. <input type="checkbox"/> Other (specify):

Was a chemical/bacteriological sample submitted to KDHE? Yes No If yes, date sample was submitted:
 Water well disinfected? Yes No

8 TYPE OF CASING USED: Steel PVC Other CASING JOINTS: Glued Clamped Welded Threaded
 Casing diameter 4 in. to 71 ft., Diameter in. to ft., Diameter in. to ft.
 Casing height above land surface -0.48 in. Weight 2.071 lbs./ft. Wall thickness or gauge No. 237
TYPE OF SCREEN OR PERFORATION MATERIAL:
 Steel Stainless Steel Fiberglass PVC Other (Specify)
 Brass Galvanized Steel Concrete tile None used (open hole)
SCREEN OR PERFORATION OPENINGS ARE:
 Continuous Slot Mill Slot Gauze Wrapped Torch Cut Drilled Holes Other (Specify)
 Louvered Shutter Key Punched Wire Wrapped Saw Cut None (Open Hole)
SCREEN-PERFORATED INTERVALS: From 71 ft. to 101 ft., From (KA) ft. to ft., From ft. to ft.
GRAVEL PACK INTERVALS: From 68 ft. to 104 ft., From ft. to ft., From ft. to ft.

9 GROUT MATERIAL: Neat cement Cement grout Bentonite Other
 Grout Intervals: From 0 ft. to 2 ft., From 2 ft. to 68 ft., From ft. to ft.
Nearest source of possible contamination:
 Septic Tank Lateral Lines Pit Privy Livestock Pens Insecticide Storage
 Sewer Lines Cess Pool Sewage Lagoon Fuel Storage Abandoned Water Well
 Watertight Sewer Lines Seepage Pit Feedyard Fertilizer Storage Oil Well/Gas Well
 Other (Specify)
 Direction from well? Distance from well? ft.

10 FROM	TO	LITHOLOGIC LOG	FROM	TO	LITHO. LOG (cont.) or PLUGGING INTERVALS
0	2	clay-lt brn	79	91	snd--lt brn-vf-c/f grvl, loose
2	14	snd- st brn-vf -m gr/caliche	91	94	snd-brn, vf-c gr/caliche
14	25	snd-st brn-vf cal/tr grvl	94	104	clv-st brn, silty-sndy/snd strks
25	30	aa/med cemented			
30	40	snd--st brn-vf/f grvl/caliche			
40	48	snd--st brn-vf-c gr, loose			
48	58	clv--lt brn, sndy, slstc, snd strks	Notes:		
58	70	snd--st brn, vf-c gr, loose			
70	79	clv-lt brn-lt red brn, sndy-silty, plstic/snd st			

11 CONTRACTOR'S OR LANDOWNER'S CERTIFICATION: This water well was constructed, reconstructed, or plugged under my jurisdiction and was completed on (mo-day-year) 04/15/2013 and this record is true to the best of my knowledge and belief. Kansas Water Well Contractor's License No. 554. This Water Well Record was completed on (mo-day-year) 04/29/2013 under the business name of Woofler Pump & Well, Inc.