


1 LOCATION OF WATER WELL: Fraction NW 1/4 SW 1/4 SW 1/4 SE 1/4 Section Number 26 Township Number 26T S Range Number 25 E W
 County: FORD

Street/Rural Address of Well Location; if unknown, distance & direction from nearest town or intersection: If at owner's address, check here 809 Willroads Graven Rd Dodge City, KS 67801

Global Positioning Systems (GPS) information:
 Latitude: 37.737980 (in decimal degrees)
 Longitude: 100.005498 (in decimal degrees)
 Elevation: 2481
 Datum: WGS84, NAD83, NAD27
 Collection Method:

2 WATER WELL OWNER: Laverne Million
 RR#, St. Address, Box #: SW 637 18th St.
 City, State ZIP Code: Fayette AL 35565

GPS unit (Make/Model: _____)
 Digital Map/Photo, Topographic Map, Land Survey
 Est. Accuracy: <3 m, 3-5 m, 5-15 m, >15 m

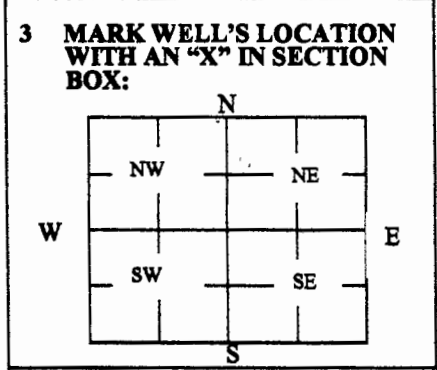

4 DEPTH OF WELL 70 ft.
WELL'S STATIC WATER LEVEL 414 ft.
WELL WAS USED AS:
 Domestic Public Water Supply Dewatering
 Irrigation Oil Field Water Supply Monitoring
 Feedlot Domestic (Lawn & Garden) Injection Well
 Industrial Air Conditioning Other _____
 Was a chemical/bacteriological sample submitted to Department? Yes No

5 TYPE OF BLANK CASING USED:
 Steel RMP (SR) Wrought Fiberglass Other (Specify below)
 PVC ABS Asbestos-Cement Concrete Tile _____
 Blank casing diameter _____ in. Was casing pulled? Yes No If yes, how much _____
 Casing height above or below land surface 10 in.

6 GROUT PLUG MATERIAL: Neat cement Cement grout Bentonite Other _____
 Grout Plug Intervals: From 0 ft. to 70 ft., From _____ ft. to _____ ft., From _____ ft. to _____ ft.
 What is the nearest source of possible contamination:
 Septic tank Seepage pit Fuel storage Other (specify below) _____
 Sewer lines Pit privy Fertilizer storage _____
 Watertight sewer lines Sewage lagoon Insecticide storage _____
 Lateral lines Feedyard Abandoned water well Oil well/Gas well Direction from well? West
 Cess pool Livestock pens How many feet? 100

FROM	TO	PLUGGING MATERIALS	FROM	TO	PLUGGING MATERIALS
0	15	Cement Grout			
15	70	Bentonite Grout			

7 CONTRACTOR'S OR LANDOWNER'S CERTIFICATION: This water well was plugged under my jurisdiction and was completed on (mo/day/year) 09/26/2016 and this record is true to the best of my knowledge and belief. Kansas Water Well Contractor's License No. 846. This Water Well Record was completed on (mo/day/year) 09/26/2016 under the business name of Nash Water Well Service, LLC by (signature) [Signature]

INSTRUCTIONS: Use typewriter or ballpoint pen. Please press firmly and print clearly. Please fill in blanks, underline or circle the correct answers. Send top three copies to Kansas Department of Health and Environment, Bureau of Water, Geology Section, 1000 SW Jackson St., Ste. 420, Topeka, Kansas 66612-1367. Telephone: 785/296-5524. Send one to Water Well Owner and retain one for your records. Visit us at <http://www.kdheks.gov/waterwell/index.html>.