

# WATER WELL PLUGGING RECORD Form WWC-5P

KSA 82a-1212 ID NO.  


**1 LOCATION OF WATER WELL:**  
 County: FORD Fraction: SE 1/4 SE 1/4 SE 1/4 Section Number: 21 Township Number: T 26 S Range Number: 25 E

Street/Rural Address of Well Location; if unknown, distance & direction from nearest town or intersection: If at owner's address, check here

**Global Positioning Systems (GPS) information:**  
 Latitude: N 3745.972 (in decimal degrees)  
 Longitude: W 10003.110 (in decimal degrees)  
 Elevation: 2627 2601  
 Horizontal Datum:  WGS84,  NAD83,  NAD27  
 Collection Method:

**2 WATER WELL OWNER:** Larry Fleming  
 RR#, St. Address, Box #: 1813 Math Downhome  
 City, State ZIP Code: Dodge City, Ks 67801

GPS unit (Make/Model): E trex 30 Kolar  
 Digital Map/Photo,  Topographic Map,  Land Survey  
 Est. Accuracy:  < 3 m,  3-5 m,  5-15 m,  > 15 m

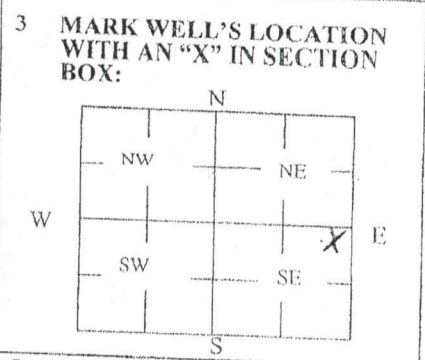

**4 DEPTH OF WELL** 233 ft.  
 WELL'S STATIC WATER LEVEL 146 ft.  
 WELL WAS USED AS:  
 Domestic  Public Water Supply  Dewatering  
 Irrigation  Oil Field Water Supply  Monitoring  
 Feedlot  Domestic (Lawn & Garden)  Injection Well  
 Industrial  Air Conditioning  Other  
 Was a chemical/bacteriological sample submitted to Department? Yes  No

N 37.766335  
W 100.051864

**5 TYPE OF BLANK CASING USED:**  
 Steel  RMP (SR)  Wrought  Fiberglass  Other (Specify below)  
 PVC  ABS  Asbestos-Cement  Concrete Tile  
 Blank casing diameter 6 in. Was casing pulled? Yes  No  If yes, how much \_\_\_\_\_  
 Casing height above or below land surface 60 in.

**6 GROUT PLUG MATERIAL:**  Neat cement  Cement grout  Bentonite  Other \_\_\_\_\_  
 Grout Plug Intervals: From 5 ft. to 233 ft., From \_\_\_\_\_ ft. to \_\_\_\_\_ ft., From \_\_\_\_\_ ft. to \_\_\_\_\_ ft.  
 What is the nearest source of possible contamination:  
 Septic tank  Seepage pit  Fuel storage  Other (specify below)  
 Sewer lines  Pit privy  Fertilizer storage Rural Sewer  
 Watertight sewer lines  Sewage lagoon  Insecticide storage  
 Lateral lines  Feedyard  Abandoned water well West  
 Cess pool  Livestock pens  Oil well/Gas well 60 ft.  
 Direction from well? West  
 How many feet? 60 ft.

FROM	TO	PLUGGING MATERIALS	FROM	TO	PLUGGING MATERIALS
<u>5</u>	<u>233</u>	<u>Bentonite</u>			
		<u>chlorate well</u>			

**7 CONTRACTOR'S OR LANDOWNER'S CERTIFICATION:** This water well was plugged under my jurisdiction and was completed on (mo/day/year) 5-31-19 and this record is true to the best of my knowledge and belief. Kansas Water Well Contractor's License No. 172. This Water Well Record was completed on (mo/day/year) 6-10-19 under the business name of Tonagan Water Well Service LLC by (signature) mpg

Send one white copy to Kansas Department of Health & Environment, Geology Section, 1000 SW Jackson Street, Ste. 420, Topeka, KS 66612-1367. Send one copy to WATER WELL OWNER and retain one for your records.  
 Visit us at <http://www.kdheks.gov/waterwell/index.html> Telephone 785-296-5524.