


**1 LOCATION OF WATER WELL:**  Fraction County: Jard   $SE \frac{1}{4} SE \frac{1}{4} SE \frac{1}{4} SE \frac{1}{4}$  Section Number 7 Township Number T 26 S Range Number 25  E  W

Street/Rural Address of Well Location; if unknown, distance & direction from nearest town or intersection: If at owner's address, check here  2 m. S of Garnet Rd & 107th west side.  
**Global Positioning Systems (GPS) information:**  
 Latitude: 37° 7.742' N 37° 7.742' N (in decimal degrees)  
 Longitude: 100° 5.319' W (in decimal degrees)  
 Elevation: 2604 2614 W 100 = 688.678  
 Horizontal Datum:  WGS84,  NAD83,  NAD27  
 Collection Method:  

**2 WATER WELL OWNER:** Robert Haskell  
 RR#, St. Address, Box #: 701 E. Commack Lane  
 City, State ZIP Code: Ridge City, KS 67801 Suite B  
 GPS unit (Make/Model): Garmin TreX30  
 Digital Map/Photo,  Topographic Map,  Land Survey  
 Est. Accuracy:  < 3 m,  3-5 m,  5-15 m,  > 15 m Koltr

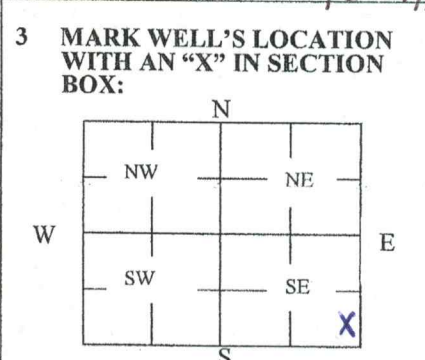

**4 DEPTH OF WELL** 136 ft.  
 WELL'S STATIC WATER LEVEL 0 ft  
 WELL WAS USED AS:  
 Domestic  Public Water Supply  Dewatering  
 Irrigation  Oil Field Water Supply  Monitoring  
 Feedlot  Domestic (Lawn & Garden)  Injection Well  
 Industrial  Air Conditioning  Other Stock  
 Was a chemical/bacteriological sample submitted to Department? Yes  No

**5 TYPE OF BLANK CASING USED:**  
 Steel  RMP (SR)  Wrought  Fiberglass  Other (Specify below)  
 PVC  ABS  Asbestos-Cement  Concrete Tile  
 Blank casing diameter 4 in. Was casing pulled? Yes  No  If yes, how much    
 Casing height above or below land surface 60 in.

**6 GROUT PLUG MATERIAL:**  Neat cement  Cement grout  Bentonite  Other    
 Grout Plug Intervals: From 5 ft. to 136 ft., From   ft. to   ft., From   ft. to   ft.  
 What is the nearest source of possible contamination:  
 Septic tank  Seepage pit  Fuel storage  Other (specify below)  
 Sewer lines  Pit privy  Fertilizer storage  
 Watertight sewer lines  Sewage lagoon  Insecticide storage  
 Lateral lines  Feedyard  Abandoned water well  
 Cess pool  Livestock pens  Oil well/Gas well  
 Direction from well? SW  
 How many feet? 3, 20ft.

FROM	TO	PLUGGING MATERIALS	FROM	TO	PLUGGING MATERIALS
<u>5</u>	<u>136</u>	<u>Bentonite</u>			
		<u>chlorinate</u>			

Original Returned to Sender  
 or Correction Date: 7/9/19

**7 CONTRACTOR'S OR LANDOWNER'S CERTIFICATION:** This water well was plugged under my jurisdiction and was completed on (mo/day/year) 10-20-18 and this record is true to the best of my knowledge and belief. Kansas Water Well Contractor's License No. 172. This Water Well Record was completed on (mo/day/year) 11-1-18 under the business name of Tonagan Water Well Service by (signature) [Signature]

Send one white copy to Kansas Department of Health & Environment, Geology Section, 1000 SW Jackson Street, Ste. 420, Topeka, KS 66612-1367. Send one copy to WATER WELL OWNER and retain one for your records.  
 Visit us at <http://www.kdheks.gov/waterwell/index.html> Telephone 785-296-5524.