

**WATER WELL PLUGGING RECORD Form WWC-5P KSA 82a-1212 ID NO.**


N/A

**1 LOCATION OF WATER WELL:** Fraction 1/4 NW 1/4 SE 1/4 NW 1/4 Section Number 36 Township Number T 26 S Range Number 25  E  W  
 County: FORD

Street/Rural Address of Well Location: if unknown, distance & direction from nearest town or intersection: If at owner's address, check here  From the intersection of Cherry St. and Beta Rd. approx. 2/10 mile East

**2 WATER WELL OWNER:** Water Sports Campground  
 RR#, St. Address, Box #: 500 E Cherry  
 City, State ZIP Code: Dodge City Ks., 67801

**Global Positioning Systems (GPS) information:**  
 Latitude: 37.74496 (in decimal degrees)  
 Longitude: -100.00902 (in decimal degrees)  
 Elevation: \_\_\_\_\_  
 Datum:  WGS84,  NAD83,  NAD27  
 Collection Method: \_\_\_\_\_  
 GPS unit (Make/Model: Garmin eTrex 10)  
 Digital Map/Photo,  Topographic Map,  Land Survey  
 Est. Accuracy:  < 3 m,  3-5 m,  5-15 m,  > 15 m

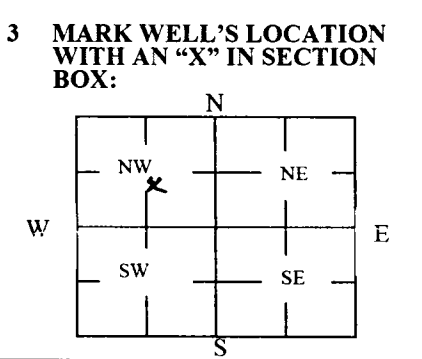

**4 DEPTH OF WELL** 12' ft.  
 WELL'S STATIC WATER LEVEL No Water ft  
 WELL WAS USED AS:  
 Domestic  Public Water Supply  Dewatering  
 Irrigation  Oil Field Water Supply  Monitoring  
 Feedlot  Domestic (Lawn & Garden)  Injection Well  
 Industrial  Air Conditioning  Other \_\_\_\_\_  
 Was a chemical/bacteriological sample submitted to Department? Yes  No

**5 TYPE OF BLANK CASING USED:**  
 Steel  RMP (SR)  Wrought  Fiberglass  Other (Specify below) \_\_\_\_\_  
 PVC  ABS  Asbestos-Cement  Concrete Tile  
 Blank casing diameter 16" in. Was casing pulled? Yes  No  If yes, how much 60"  
 Casing height above or below land surface Below 60" in.

**6 GROUT PLUG MATERIAL:**  Neat cement  Cement grout  Bentonite  Other \_\_\_\_\_  
 Grout Plug Intervals: From 12' ft. to 5' ft., From \_\_\_\_\_ ft. to \_\_\_\_\_ ft., From \_\_\_\_\_ to \_\_\_\_\_ ft.  
 What is the nearest source of possible contamination:  
 Septic tank  Seepage pit  Fuel Storage  Other (specify below) \_\_\_\_\_  
 Sewer lines  Pit privy  Fertilizer storage  None Observed  
 Watertight sewer lines  Sewage lagoon  Insecticide storage  
 Lateral lines  Feedyard  Abandoned water well Direction from well? \_\_\_\_\_  
 Cess pool  Livestock pens  Oil well/Gas well How many feet? \_\_\_\_\_

| FROM | TO | PLUGGING MATERIALS | FROM | TO | PLUGGING MATERIALS            |
|------|----|--------------------|------|----|-------------------------------|
| 12'  | 5' | 3,000 PSI CONCRETE | 5'   | 0' | Cut off casing and Backfilled |
|      |    |                    |      |    |                               |
|      |    |                    |      |    |                               |
**7 CONTRACTOR'S OR LANDOWNER'S CERTIFICATION:** This water well was plugged under my jurisdiction and was completed on (mo/day/year) 5-25-2021 and this record is true to the best of my knowledge and belief. Kansas Water Well Contractor's License No. 145. This Water Well Record was completed on (mo/day/year) 5-27-2021 under the business name of Hydro Resources Mid Continent by (signature) Gary Clepper

**INSTRUCTIONS:** Use typewriter or ballpoint pen. Please press firmly and print clearly. Please fill in blanks, underline or circle the correct answers. Send top three copies to Kansas Department of Health and Environment, Bureau of Water, Geology Section, 1000 SW Jackson St., Ste. 420, Topeka, Kansas 66612-1367. Telephone: 785/296-5524. Send one to Water Well Owner and retain one for your records. Visit us at <http://www.kdheks.gov/waterwell/index.html>.

Check one:  White Copy  Blue Copy  Pink Copy