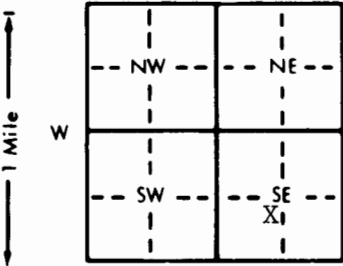


1 LOCATION OF WATER WELL:		Fraction		Section Number		Township Number		Range Number	
County: <u>Ford</u>		<u>NE 1/4</u> <u>SW 1/4</u> <u>SE 1/4</u>		<u>27</u>		<u>T 26 S</u>		<u>R 25 E</u>	
Distance and direction from nearest town or city street address of well if located within city? <u>1908 Wyatt Earp, Dodge City, KS</u>	
2 WATER WELL OWNER: <u>Associated Milk Producers, Inc</u>	
RR#, St. Address, Box # : <u>P.O. Box 540</u>						Board of Agriculture, Division of Water Resources	
City, State, ZIP Code : <u>Arlington, TX 76005-0540</u>						Application Number:	
3 LOCATE WELL'S LOCATION WITH AN "X" IN SECTION BOX:		4 DEPTH OF COMPLETED WELL: <u>59</u> ft. ELEVATION: <u>44.91</u> ft.	
<div style="text-align: center;"></div>		Depth(s) Groundwater Encountered <u>1</u> <u>42</u> ft. <u>2</u> <u>91</u> ft. <u>3</u> <u>ft.</u>	
		WELL'S STATIC WATER LEVEL <u>42</u> ft. below land surface measured on mo/day/yr	
		Pump test data: Well water was <u>ft.</u> after <u>hours</u> pumping <u>gpm</u>	
		Est. Yield <u>gpm</u> Well water was <u>ft.</u> after <u>hours</u> pumping <u>gpm</u>	
Bore Hole Diameter <u>7 1/2</u> in. to <u>59</u> ft., and <u>in.</u> to <u>ft.</u>	
WELL WATER TO BE USED AS:	
1 Domestic 3 Feedlot 6 Oil field water supply 8 Air conditioning 11 Injection well	
2 Irrigation 4 Industrial 7 Lawn and garden only 9 Dewatering 12 Other (Specify below)	
6 Monitoring well <u>MW-3</u>	
Was a chemical/bacteriological sample submitted to Department? Yes <u>No</u> <u>X</u> ; If yes, mo/day/yr sample was submitted	
Water Well Disinfected? Yes <u>No</u>	
5 TYPE OF BLANK CASING USED:	
1 Steel 3 RMP (SR) 5 Wrought iron 8 Concrete tile CASING JOINTS: Glued <u>Clamped</u>	
2 PVC 4 ABS 6 Asbestos-Cement 9 Other (specify below) Welded <u>Threaded</u> <u>X</u>	
7 Fiberglass	
Blank casing diameter <u>2.0</u> in. to <u>39</u> ft., Dia <u>in.</u> to <u>ft.</u> , Dia <u>in.</u> to <u>ft.</u>	
Casing height above land surface <u>0.0</u> in., weight <u>lbs./ft.</u> Wall thickness or gauge No. <u>Schd 40</u>	
TYPE OF SCREEN OR PERFORATION MATERIAL:	
1 Steel 3 Stainless steel 5 Fiberglass 8 RMP (SR) 10 Asbestos-cement	
2 Brass 4 Galvanized steel 6 Concrete tile 9 ABS 11 Other (specify)	
12 None used (open hole)	
SCREEN OR PERFORATION OPENINGS ARE:	
1 Continuous slot 3 Mill slot 5 Gauzed wrapped 8 Saw cut 11 None (open hole)	
2 Louvered shutter 4 Key punched 6 Wire wrapped 9 Drilled holes	
7 Torch cut 10 Other (specify)	
SCREEN-PERFORATED INTERVALS: From <u>59</u> ft. to <u>39</u> ft., From <u>ft.</u> to <u>ft.</u>	
From <u>ft.</u> to <u>ft.</u> , From <u>ft.</u> to <u>ft.</u>	
GRAVEL PACK INTERVALS: From <u>59</u> ft. to <u>37</u> ft., From <u>ft.</u> to <u>ft.</u>	
From <u>ft.</u> to <u>ft.</u> , From <u>ft.</u> to <u>ft.</u>	
6 GROUT MATERIAL: 1 Neat cement 2 Cement grout 3 Bentonite 4 Other	
Grout Intervals: From <u>37</u> ft. to <u>0.0</u> ft., From <u>ft.</u> to <u>ft.</u> , From <u>ft.</u> to <u>ft.</u>	
What is the nearest source of possible contamination:	
1 Septic tank 4 Lateral lines 7 Pit privy 10 Livestock pens 14 Abandoned water well	
2 Sewer lines 5 Cess pool 8 Sewage lagoon 11 Fuel storage 15 Oil well/Gas well	
3 Watertight sewer lines 6 Seepage pit 9 Feedyard 12 Fertilizer storage 16 Other (specify below)	
13 Insecticide storage	
Direction from well? How many feet?	
<table border="1" style="width:100%; border-collapse: collapse;"><thead><tr><th>FROM</th><th>TO</th><th>LITHOLOGIC LOG</th><th>FROM</th><th>TO</th><th>PLUGGING INTERVALS</th></tr></thead><tbody><tr><td>0</td><td>5</td><td>Silty Clay Laom, Mod. to Dark Brown, Slightly Moist</td><td></td><td></td><td></td></tr><tr><td>5</td><td>10</td><td>Clay, Med. Brown, Lean, Slightly Moist</td><td></td><td></td><td></td></tr><tr><td>10</td><td>15</td><td>Clay, Med. Brown, Lean, Moist</td><td></td><td></td><td></td></tr><tr><td>15</td><td>20</td><td>Clay, Med. Brown, Lean, Moist</td><td></td><td></td><td></td></tr><tr><td>20</td><td>25</td><td>Clay, Med. Brown, Very Moist</td><td></td><td></td><td></td></tr><tr><td>25</td><td>30</td><td>Sand, Med. Brown, Med. to Large Grain, Some Small Gravel, Moist</td><td></td><td></td><td></td></tr><tr><td>30</td><td>35</td><td>Sand, Med. Brown, Brown, Medium to Large Grain, Some Small Gravel, Moist</td><td></td><td></td><td></td></tr><tr><td>35</td><td>40</td><td>Sand, Med. to Large Grain, Med. Brown, Gravel Small to Med., Moist</td><td></td><td></td><td></td></tr><tr><td>40</td><td>45</td><td>Sand, Med. to Large Grain, Med. Brown, Gravel Small to Large, Moist</td><td></td><td></td><td></td></tr><tr><td>45</td><td>50</td><td>Sand, Large Grain, Med. Brown, Gravel Med. to Large, Moist</td><td></td><td></td><td></td></tr><tr><td>50</td><td>55</td><td>Sand, Large Grain, Med. Brown, Gravel, Med. to Large, Moist</td><td></td><td></td><td></td></tr><tr><td>55</td><td>59</td><td>Sand, Large Grain, Med. Brown, Gravel Med. to Large, Saturated</td><td></td><td></td><td></td></tr>
7 CONTRACTOR'S OR LANDOWNER'S CERTIFICATION: This water well was <u>1</u> constructed, (2) reconstructed, or (3) plugged under my jurisdiction and was completed on (mo/day/year) <u>9-21-94</u> and this record is true to the best of my knowledge and belief. Kansas Water Well Contractor's License No. <u>540</u> This Water Well Record was completed on (mo/day/yr) <u>9-23-94</u> under the business name of <u>Prairie Land Environmental Remediation, Inc</u> (signature) <u>[Signature]</u>	
INSTRUCTIONS: Use typewriter or ball point pen. PLEASE PRESS FIRMLY and PRINT clearly. Please fill in blanks, underline or circle the correct answers. Send top three copies to Kansas Department of Health and Environment, Bureau of Water, Topeka, Kansas 66620-0001. Telephone: 913-296-5545. Send one to WATER WELL OWNER and retain one for your records.	

OFFICE USE ONLY

T

R

EW

SEC

1/4

1/4

1/4