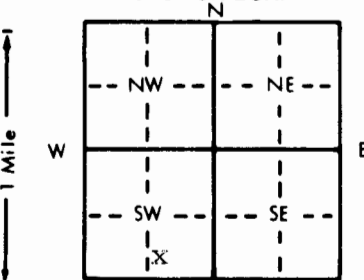


1 LOCATION OF WATER WELL:		Fraction	Section Number	Township Number	Range Number
County: FORD		SW 1/4 SE 1/4 SW 1/4	26	T 26 S	R 25 EW
Distance and direction from nearest town or city street address of well if located within city?					
710 W. TRAIL ST. DODGE CITY KS					
2 WATER WELL OWNER: DODGE CITY COOP					
RR#, St. Address, Box # : DODGE CITY KS 710 W TRAIL ST			Board of Agriculture, Division of Water Resources		
City, State, ZIP Code : 67801			Application Number:		
3 LOCATE WELL'S LOCATION WITH AN "X" IN SECTION BOX:		4 DEPTH OF COMPLETED WELL: 35 ft. ELEVATION:			
		Depth(s) Groundwater Encountered 1. 2.8 ft. 2. ft. 3. ft.			
		WELL'S STATIC WATER LEVEL: 0 ft. below land surface measured on mo/day/yr			
		Pump test data: Well water was ft. after hours pumping gpm			
		Est. Yield gpm: Well water was ft. after hours pumping gpm			
		Bore Hole Diameter: 7 1/4 in. to 35 ft. and in. to ft.			
		WELL WATER TO BE USED AS:			
		5 Public water supply 8 Air conditioning 11 Injection well			
		1 Domestic 3 Feedlot 6 Oil field water supply 9 Dewatering 12 Other (Specify below)			
		2 Irrigation 4 Industrial 7 Lawn and garden only 10 Monitoring well SPARGE POINT			
		Was a chemical/bacteriological sample submitted to Department? Yes.....No.....; If yes, mo/day/yr sample was submitted			
		Water Well Disinfected? Yes No			
5 TYPE OF BLANK CASING USED:					
1 Steel 3 RMP (SR) 5 Wrought iron 8 Concrete tile CASING JOINTS: Glued Clamped					
2 PVC 4 ABS 6 Asbestos-Cement 9 Other (specify below) Welded					
7 Fiberglass Threaded					
Blank casing diameter 1 1/4 in. to ft. Dia. in. to ft. Dia. in. to ft.					
Casing height above land surface 0.3 in., weight SCHED. 40 lbs./ft. Wall thickness or gauge No.					
TYPE OF SCREEN OR PERFORATION MATERIAL:					
1 Steel 2 Stainless steel 5 Fiberglass 8 RMP (SR) 11 Other (specify)					
2 Brass 4 Galvanized steel 6 Concrete tile 9 ABS 12 None used (open hole)					
SCREEN OR PERFORATION OPENINGS ARE:					
1 Continuous slot 2 Mill slot 5 Gauzed wrapped 8 Saw cut 11 None (open hole)					
2 Louvered shutter 4 Key punched 6 Wire wrapped 9 Drilled holes					
7 Torch cut 10 Other (specify)					
SCREEN-PERFORATED INTERVALS: From 35 ft. to 33 ft. From ft. to ft.					
From ft. to ft. From ft. to ft.					
GRAVEL PACK INTERVALS: From 35 ft. to 32 ft. From ft. to ft.					
From ft. to ft. From ft. to ft.					
6 GROUT MATERIAL:					
1 Neat cement 2 Cement grout 3 Bentonite 4 Other					
Grout Intervals: From 30 ft. to 0.6 ft. From ft. to ft. From ft. to ft.					
What is the nearest source of possible contamination:					
1 Septic tank 4 Lateral lines 7 Pit privy 10 Livestock pens 14 Abandoned water well					
2 Sewer lines 5 Cess pool 8 Sewage lagoon 11 Fuel storage 15 Oil well/Gas well					
3 Watertight sewer lines 6 Seepage pit 9 Feedyard 12 Fertilizer storage 16 Other (specify below)					
13 Insecticide storage					
Direction from well? NE How many feet? 95					
FROM TO LITHOLOGIC LOG FROM TO PLUGGING INTERVALS					
0 0.6 CONCRETE					
0.6 5 TOPSOIL					
5 10 BRN CLAY					
10 15 BRN TAN CLAYEY SAND					
15 20 FINE SAND BLK STAINING					
20 25 MEDIUM SAND					
25 30 " "					
30 35 MEDIUM TO COURSE SAND					
7 CONTRACTOR'S OR LANDOWNER'S CERTIFICATION: This water well was (1) constructed, (2) reconstructed, or (3) plugged under my jurisdiction and was completed on (mo/day/year) 12-6-94 and this record is true to the best of my knowledge and belief. Kansas Water Well Contractor's License No. 575 This Water Well Record was completed on (mo/day/yr) 1-3-95 under the business name of KURTZ ENVIRONMENTAL SERVICE by (signature)					
INSTRUCTIONS: Use typewriter or ball point pen. PLEASE PRESS FIRMLY and PRINT clearly. Please fill in blanks, underline or circle the correct answers. Send top three copies to Kansas Department of Health and Environment, Bureau of Water, Topeka, Kansas 66620-0001. Telephone: 913-296-5545. Send one to WATER WELL OWNER and retain one for your records.					

OFFICE USE ONLY

1

五

EW

SEC

 $\frac{1}{4}$

2

10