


1 LOCATION OF WATER WELL: County: FORD	Fraction SW 1/4 SE 1/4 SW 1/4	Section Number 26	Township Number T 26 S	Range Number R 25 EW
---	----------------------------------	----------------------	---------------------------	-------------------------

Distance and direction from nearest town or city street address of well if located within city?
710 W. TRAIL ST DODGE CITY KS 67801

2 WATER WELL OWNER: DODGE CITY COOP
RR#, St. Address, Box # : 710 W. TRAIL ST Board of Agriculture, Division of Water Resources
City, State, ZIP Code : DODGE CITY KS 67801 Application Number:

3 LOCATE WELL'S LOCATION WITH AN "X" IN SECTION BOX:

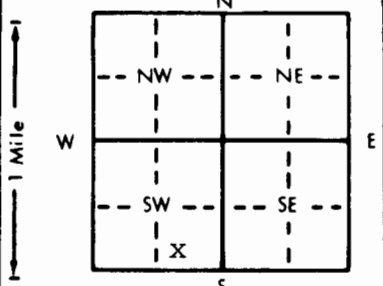

4 DEPTH OF COMPLETED WELL... 35 ft. ELEVATION: ...
Depth(s) Groundwater Encountered 1. 28 ft. 2. ft. 3. ft.
WELL'S STATIC WATER LEVEL ... 28 ft. below land surface measured on mo/day/yr

Pump test data: Well water was ... ft. after ... hours pumping ... gpm
Est. Yield ... gpm: Well water was ... ft. after ... hours pumping ... gpm
Bore Hole Diameter... 7 1/4 in. to 35 ft., and ... in. to ... ft.
WELL WATER TO BE USED AS: 5 Public water supply 8 Air conditioning 11 Injection well
1 Domestic 3 Feedlot 6 Oil field water supply 9 Dewatering x12 Other (Specify below)
2 Irrigation 4 Industrial 7 Lawn and garden only 10 Monitoring well ... SPARGE POINT ...
Was a chemical/bacteriological sample submitted to Department? Yes ... No ...; If yes, mo/day/yr sample was submitted
Water Well Disinfected? Yes No

5 TYPE OF BLANK CASING USED:
1 Steel 3 RMP (SR) 5 Wrought iron 8 Concrete tile CASING JOINTS: Glued Clamped
x PVC 4 ABS 6 Asbestos-Cement 9 Other (specify below) Welded
7 Fiberglass Threaded

Blank casing diameter ... 1 1/4 in. to 33 ft., Dia ... in. to ... ft., Dia ... in. to ... ft.
Casing height above land surface ... 0.3 in., weight sched 40 lbs./ft. Wall thickness or gauge No. ...
TYPE OF SCREEN OR PERFORATION MATERIAL:
1 Steel x3 Stainless steel 5 Fiberglass 7 PVC 10 Asbestos-cement
2 Brass 4 Galvanized steel 6 Concrete tile 8 RMP (SR) 11 Other (specify)
9 ABS 12 None used (open hole)

SCREEN OR PERFORATION OPENINGS ARE:
1 Continuous slot x Mill slot 5 Gauzed wrapped 8 Saw cut 11 None (open hole)
2 Louvered shutter 4 Key punched 6 Wire wrapped 9 Drilled holes
7 Torch cut 10 Other (specify)

SCREEN-PERFORATED INTERVALS: From ... 35 ft. to 33 ft., From ... ft. to ... ft.
GRAVEL PACK INTERVALS: From ... 35 ft. to 32 ft., From ... ft. to ... ft.

6 GROUT MATERIAL: 1 Neat cement x Cement grout 3 Bentonite 4 Other
Grout intervals: From ... 30 ft. to ... 0.6 ft., From ... ft. to ... ft., From ... ft. to ... ft.

What is the nearest source of possible contamination:
1 Septic tank 4 Lateral lines 7 Pit privy 10 Livestock pens 14 Abandoned water well
2 Sewer lines 5 Cess pool 8 Sewage lagoon 1x Fuel storage 15 Oil well/Gas well
3 Watertight sewer lines 6 Seepage pit 9 Feedyard 12 Fertilizer storage 16 Other (specify below)
13 Insecticide storage

Direction from well? NE How many feet? 171

FROM	TO	LITHOLOGIC LOG	FROM	TO	PLUGGING INTERVALS
0	0.6	CONCRETE			
0.6	5	TOPSOIL			
5	10	BRN CLAY			
10	15	FINE TAN CLAYEY SAND			
15	20	FINE TO MEDIUM SAND BLK STAINING			
20	25	MEDIUM SAND			
25	30	" "			
30	35	MEDIUM TO COURSE SAND			

7 CONTRACTOR'S OR LANDOWNER'S CERTIFICATION: This water well was (1) constructed, (2) reconstructed, or (3) plugged under my jurisdiction and was completed on (mo/day/year) ... 12-6-94 ... and this record is true to the best of my knowledge and belief. Kansas Water Well Contractor's License No. ... 575 ... This Water Well Record was completed on (mo/day/yr) ... 1-3-95 ... under the business name of KURTZ ENVIRONMENTAL SERVICE by (signature)

OFFICE USE ONLY T R EW SEC. 1/4 1/4 1/4