


1 LOCATION OF WATER WELL: County: FORD	Fraction SE 1/4 SE 1/4 SW 1/4	Section Number 26	Township Number T 26 S	Range Number R 25 E/W
---	----------------------------------	----------------------	---------------------------	--------------------------

Distance and direction from nearest town or city street address of well if located within city?
710 W. TRAIL ST. DODGE CITY KS. 67801

2 WATER WELL OWNER: DODGE CITY COOP
RR#, St. Address, Box #: 710 W. TRAIL ST.
City, State, ZIP Code: DODGE CITY KS. 67801

Board of Agriculture, Division of Water Resources
Application Number:

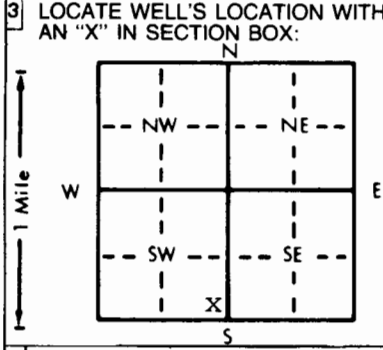

4 DEPTH OF COMPLETED WELL: 33 ft. ELEVATION:

Depth(s) Groundwater Encountered 1. ft. 2. ft. 3. ft.

WELL'S STATIC WATER LEVEL: 25 ft. below land surface measured on mo/day/yr

Pump test data: Well water was _____ ft. after _____ hours pumping _____ gpm

Est. Yield _____ gpm: Well water was _____ ft. after _____ hours pumping _____ gpm

Bore Hole Diameter: 7 1/4 in. to 33 ft., and _____ in. to _____ ft.

WELL WATER TO BE USED AS:

5 Public water supply	8 Air conditioning	11 Injection well
1 Domestic	3 Feedlot	6 Oil field water supply
2 Irrigation	4 Industrial	7 Lawn and garden only
		9 Dewatering
		10 Monitoring well
		12 Other (Specify below) SPARGE POINT

Was a chemical/bacteriological sample submitted to Department? Yes.....No.....; If yes, mo/day/yr sample was submitted

Water Well Disinfected? Yes No

5 TYPE OF BLANK CASING USED:

1 Steel	3 RMP (SR)	5 Wrought iron	8 Concrete tile	CASING JOINTS: Glued	Clamped
2 PVC	4 ABS	6 Asbestos-Cement	9 Other (specify below)	Welded	
		7 Fiberglass		Threaded	

Blank casing diameter: 1 1/4 in. to 31 ft., Dia _____ in. to _____ ft., Dia _____ in. to _____ ft.

Casing height above land surface: -0.3 in., weight SCHED. 40 lbs./ft. Wall thickness or gauge No. _____

TYPE OF SCREEN OR PERFORATION MATERIAL:

1 Steel	3 Stainless steel	5 Fiberglass	8 RMP (SR)	11 Other (specify)
2 Brass	4 Galvanized steel	6 Concrete tile	9 ABS	12 None used (open hole)

SCREEN OR PERFORATION OPENINGS ARE:

1 Continuous slot	3 Mill slot	5 Gauzed wrapped	8 Saw cut	11 None (open hole)
2 Louvered shutter	4 Key punched	6 Wire wrapped	9 Drilled holes	
		7 Torch cut	10 Other (specify)	

SCREEN-PERFORATED INTERVALS: From 33 ft. to 31 ft., From _____ ft. to _____ ft.

GRAVEL PACK INTERVALS: From 33 ft. to 30 ft., From _____ ft. to _____ ft.

6 GROUT MATERIAL: 1 Neat cement 2 Cement grout 3 Bentonite 4 Other

Grout Intervals: From 29 ft. to 0.6 ft., From _____ ft. to _____ ft., From _____ ft. to _____ ft.

What is the nearest source of possible contamination:

1 Septic tank	4 Lateral lines	7 Pit privy	10 Livestock pens	14 Abandoned water well
2 Sewer lines	5 Cess pool	8 Sewage lagoon	11 Fuel storage	15 Oil well/Gas well
3 Watertight sewer lines	6 Seepage pit	9 Feedyard	12 Fertilizer storage	16 Other (specify below)
			13 Insecticide storage	

Direction from well? NW How many feet? 526

FROM	TO	LITHOLOGIC LOG	FROM	TO	PLUGGING INTERVALS
0	0.6	CONCRETE			
0.6	3	TOPSOIL			
3	10	BRN CLAY			
10	15	TAN BRN CLAYEY SAND			
15	20	FINE SAND			
20	25	FINE TO MEDIUM SAND STAINING AT			
		23 SATURATED AT 28.0			
25	30	MEDIUM TO COARSE SAND			
30	33	COARSE SAND			

7 CONTRACTOR'S OR LANDOWNER'S CERTIFICATION: This water well was (1) constructed, (2) reconstructed, or (3) plugged under my jurisdiction and was completed on (mo/day/year) 12-8-94 and this record is true to the best of my knowledge and belief. Kansas Water Well Contractor's License No. 575. This Water Well Record was completed on (mo/day/yr) 1-3-95 under the business name of KURTZ ENVIRONMENTAL SERVICE by (signature) [Signature]