


1 LOCATION OF WATER WELL:	Fraction	Section Number	Township Number	Range Number
County: Ford	NE 1/4 SE 1/4 SW 1/4	27	T 26 S	R 25 W E/W

Distance and direction from nearest town or city street address of well if located within city?

2305 W. WYATT EARP

2 WATER WELL OWNER:	Turn - A - Round	Board of Agriculture, Division of Water Resources
RR#, St. Address, Box # :	2305 W. Wyatt Earp	Application Number:
City, State, ZIP Code :	Dodge City, Kansas 67801	

3 LOCATE WELL'S LOCATION WITH AN "X" IN SECTION BOX:

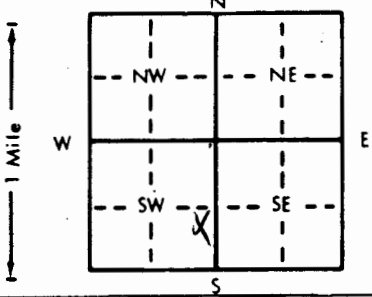

4 DEPTH OF COMPLETED WELL: 44.5 ft. ELEVATION:	
Depth(s) Groundwater Encountered 1. ft. 2. ft. 3. 2504.1 ft.	
WELL'S STATIC WATER LEVEL5 ft. below land surface measured on mo/day/yr 3/1/95	
Pump test data: Well water was ft. after hours pumping gpm	
Est. Yield NA gpm: Well water was ft. after hours pumping gpm	
Bore Hole Diameter. 8 in. to 45 ft., and in. to ft.	
WELL WATER TO BE USED AS:	
5 Public water supply 8 Air conditioning 11 Injection well	
1 Domestic 3 Feedlot 6 Oil field water supply 9 Dewatering 12 Other (Specify below)	
2 Irrigation 4 Industrial 7 Lawn and garden only 10 Monitoring well	
Was a chemical/bacteriological sample submitted to Department? Yes No X; If yes, mo/day/yr sample was submitted	
Water Well Disinfected? Yes No X	

5 TYPE OF BLANK CASING USED:	5 Wrought iron	8 Concrete tile	CASING JOINTS: Glued Clamped
1 Steel	3 RMP (SR)	6 Asbestos-Cement	9 Other (specify below)
2 PVC	4 ABS	7 Fiberglass	Welded
Blank casing diameter 2 in. to 35 ft., Dia in. to ft., Dia in. to ft.			Threaded. X
Casing height above land surface -6.4 in., weight lbs./ft. Wall thickness or gauge No. Sch. 40			
TYPE OF SCREEN OR PERFORATION MATERIAL:	7 PVC	10 Asbestos-cement	
1 Steel	3 Stainless steel	5 Fiberglass	8 RMP (SR)
2 Brass	4 Galvanized steel	6 Concrete tile	9 ABS
SCREEN OR PERFORATION OPENINGS ARE:	5 Gauzed wrapped	8 Saw cut	11 None (open hole)
1 Continuous slot	3 Mill slot	6 Wire wrapped	9 Drilled holes
2 Louvered shutter	4 Key punched	7 Torch cut	10 Other (specify)
SCREEN-PERFORATED INTERVALS: From 35 ft. to 50 ft., From ft. to ft.			
GRAVEL PACK INTERVALS: From 33 ft. to 50 ft., From ft. to ft.			

6 GROUT MATERIAL:	1 Neat cement	2 Cement grout	3 Bentonite	4 Other
Grout Intervals: From 0 ft. to 31 ft., From 31 ft. to 33 ft., From ft. to ft.				
What is the nearest source of possible contamination:	1 Septic tank	4 Lateral lines	7 Pit privy	10 Livestock pens
	2 Sewer lines	5 Cess pool	8 Sewage lagoon	11 Fuel storage
	3 Watertight sewer lines	6 Seepage pit	9 Feedyard	12 Fertilizer storage
				13 Insecticide storage
				14 Abandoned water well
				15 Oil well/Gas well
				16 Other (specify below)
				UST
Direction from well? SW			How many feet? 275	

FROM	TO	LITHOLOGIC LOG	FROM	TO	PLUGGING INTERVALS
0	4	Clay, Dark Brown			MW11
4	10	Clay, Light Brown			GeoCore # 96 Flush-mount Cover
10	20	Clay, Medium Brown			KDHE # 01029890 Tag # 119393
20	25	Clay, Dark Brown			
25	30	Sand, Light Yellow Brown			
30	34	Sand, Yellow Brown			

7 CONTRACTOR'S OR LANDOWNER'S CERTIFICATION: This water well was **1** constructed, **2** reconstructed, or **3** plugged under my jurisdiction and was completed on (mo/day/year) **3/1/95** and this record is true to the best of my knowledge and belief. Kansas Water Well Contractor's License No. **527** This Water Well Record was completed on (mo/day/yr) **3/8/95** under the business name of **GeoCore Services, Inc.** by (signature) *Aphe Robt*

INSTRUCTIONS: Use typewriter or ball point pen. PLEASE PRESS FIRMLY and PRINT clearly. Please fill in blanks, underline or circle the correct answers. Send top three copies to Kansas Department of Health and Environment, Bureau of Water, Topeka, Kansas 66620-0001. Telephone: 913-296-5545. Send one to WATER WELL OWNER and retain one for your records.