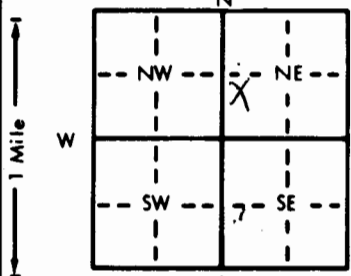


<b>1 LOCATION OF WATER WELL:</b>		<b>Fraction</b>		<b>Section Number</b>	<b>Township Number</b>		<b>Range Number</b>	
County: Ford		NW 1/4 SW 1/4 NE 1/4		12	T 26 S		R 26 <span style="border: 1px solid black; border-radius: 50%; padding: 2px;">EW</span>	
Distance and direction from nearest town or city street address of well if located within city? From Dodge City, Ks. - 5 miles West on highway 50 and 2 1/2 miles North	
<b>2 WATER WELL OWNER:</b> Rex Stanley Feedyard, Inc.	
RR#, St. Address, Box # :			R.R. 2, Box 238			Board of Agriculture, Division of Water Resources	
City, State, ZIP Code :			Dodge City, Kansas 67801			Application Number: 38,047	
<b>3 LOCATE WELL'S LOCATION WITH AN "X" IN SECTION BOX:</b>			<b>4 DEPTH OF COMPLETED WELL:</b> 220 ft. <b>ELEVATION:</b>	
<div style="text-align: center;"></div>			Depth(s) Groundwater Encountered 1. .... ft. 2. .... ft. 3. .... ft.	
			WELL'S STATIC WATER LEVEL ... 101 ... ft. below land surface measured on mo/day/yr March 29, 1986	
			Pump test data: Well water was .... ft. after .... hours pumping .... gpm	
			Est. Yield ... 75 ... gpm: Well water was .... ft. after .... hours pumping .... gpm	
			Bore Hole Diameter ... 12 ... in. to ... 220 ... ft., and ... in. to ... ft.	
<b>WELL WATER TO BE USED AS:</b>	
5 Public water supply      8 Air conditioning      11 Injection well	
1 Domestic      3 Feedlot      6 Oil field water supply      9 Dewatering      12 Other (Specify below)	
2 Irrigation      4 Industrial      7 Lawn and garden only      10 Observation well	
Was a chemical/bacteriological sample submitted to Department? Yes.....No...XX..... If yes, mo/day/yr sample was submitted	
Water Well Disinfected? Yes XX No	
<b>5 TYPE OF BLANK CASING USED:</b>	
1 Steel			3 RMP (SR)			5 Wrought iron	
2 PVC			4 ABS			6 Asbestos-Cement	
						7 Fiberglass	
Blank casing diameter ... 6 ... in. to ... 220 ... ft., Dia ... in. to ... ft., Dia ... in. to ... ft.	
Casing height above land surface ... 12 ... in., weight ... 200 psi ... lbs./ft. Wall thickness or gauge No. SDR 21	
<b>TYPE OF SCREEN OR PERFORATION MATERIAL:</b>	
1 Steel			3 Stainless steel			5 Fiberglass	
2 Brass			4 Galvanized steel			6 Concrete tile	
						7 PVC	
						8 RMP (SR)	
						9 ABS	
						10 Asbestos-cement	
						11 Other (specify) .....	
						12 None used (open hole)	
<b>SCREEN OR PERFORATION OPENINGS ARE:</b>	
1 Continuous slot			3 Mill slot			5 Gauzed wrapped	
2 Louvered shutter			4 Key punched			6 Wire wrapped	
						7 Torch cut	
						8 Saw cut	
						9 Drilled holes	
						10 Other (specify) .....	
						11 None (open hole)	
<b>SCREEN-PERFORATED INTERVALS:</b> From ... 185 ... ft. to ... 215 ... ft., From ... ft. to ... ft.	
From ... ft. to ... ft., From ... ft. to ... ft.	
<b>GRAVEL PACK INTERVALS:</b> From ... 20 ... ft. to ... 220 ... ft., From ... ft. to ... ft.	
From ... ft. to ... ft., From ... ft. to ... ft.	
<b>6 GROUT MATERIAL:</b> 1 Neat cement      2 Cement grout      3 Bentonite      4 Other .....	
Grout Intervals: From ... 5 ... ft. to ... 20 ... ft., From ... ft. to ... ft., From ... ft. to ... ft.	
What is the nearest source of possible contamination:	
1 Septic tank			4 Lateral lines			7 Pit privy	
2 Sewer lines			5 Cess pool			8 Sewage lagoon	
3 Watertight sewer lines			6 Seepage pit			9 Feedyard	
						10 Livestock pens	
						11 Fuel storage	
						12 Fertilizer storage	
						13 Insecticide storage	
						14 Abandoned water well	
						15 Oil well/Gas well	
						16 Other (specify below)	
Direction from well? North						How many feet? 50	
<table border="1" style="width:100%; border-collapse: collapse;"><thead><tr><th>FROM</th><th>TO</th><th>LITHOLOGIC LOG</th><th>FROM</th><th>TO</th><th>LITHOLOGIC LOG</th></tr></thead><tbody><tr><td>0</td><td>15</td><td>Top soil &amp; clay</td><td></td><td></td><td></td></tr><tr><td>15</td><td>30</td><td>Clay &amp; cleechie</td><td></td><td></td><td></td></tr><tr><td>30</td><td>45</td><td>Cleechie &amp; clay</td><td></td><td></td><td></td></tr><tr><td>45</td><td>60</td><td>Clay &amp; sand rock layers</td><td></td><td></td><td></td></tr><tr><td>60</td><td>75</td><td>Sand rock &amp; fine to medium sand in layers</td><td></td><td></td><td></td></tr><tr><td>75</td><td>90</td><td>Medium sand (3 ft.), clay (5 ft.) &amp; fine to medium sand</td><td></td><td></td><td></td></tr><tr><td>90</td><td>120</td><td>Fine to coarse sand</td><td></td><td></td><td></td></tr><tr><td>120</td><td>135</td><td>Fine to medium sand &amp; clay (3 ft.)</td><td></td><td></td><td></td></tr><tr><td>135</td><td>150</td><td>Clay (5 ft.) &amp; fine sand</td><td></td><td></td><td></td></tr><tr><td>150</td><td>165</td><td>Fine sand &amp; clay</td><td></td><td></td><td></td></tr><tr><td>165</td><td>180</td><td>Clay (3 ft.) &amp; fine sand</td><td></td><td></td><td></td></tr><tr><td>180</td><td>195</td><td>Fine to medium sand</td><td></td><td></td><td></td></tr><tr><td>195</td><td>210</td><td>Medium to coarse sand</td><td></td><td></td><td></td></tr><tr><td>210</td><td>215</td><td>Coarse sand</td><td></td><td></td><td></td></tr><tr><td>215</td><td>255</td><td>Blue shale</td><td></td><td></td><td></td></tr>
<b>7 CONTRACTOR'S OR LANDOWNER'S CERTIFICATION:</b> This water well was (1) constructed, (2) reconstructed, or (3) plugged under my jurisdiction and was completed on (mo/day/year) April 24, 1986 and this record is true to the best of my knowledge and belief. Kansas	
Water Well Contractor's License No. 179 This Water Well Record was completed on (mo/day/yr) June 21, 1986	
under the business name of Joe's Well Service, Inc. Cimarron, Ks. by (signature) Larry Crick	
INSTRUCTIONS: Use typewriter or ball point pen. PLEASE PRESS FIRMLY and PRINT clearly. Please fill in blanks, underline or circle the correct answers. Send top three copies to Kansas Department of Health and Environment, Office of Oil Field and Environmental Geology, Regulation and Permitting Section, Topeka, Kansas 66620-7500, Telephone: 913-862-9360. Send one to WATER WELL OWNER and retain one for your records.	