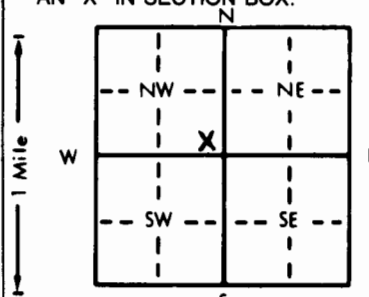


1 LOCATION OF WATER WELL:	Fraction	Section Number	Township Number	Range Number
County: Ford	SE 1/4 SE 1/4 NW 1/4	17	T 26 S	R 26 <u>EW</u>

Distance and direction from nearest town or city street address of well if located within city?

From Cimarron, Ks. - 7 miles east on highway 50

2 WATER WELL OWNER: Dr. Allen Reynolds	Board of Agriculture, Division of Water Resources
RR#, St. Address, Box #: 2500 Hart	Application Number:
City, State, ZIP Code: Dodge City, Kansas 67801	

3 LOCATE WELL'S LOCATION WITH AN "X" IN SECTION BOX:	4 DEPTH OF COMPLETED WELL: 195 ft. ELEVATION:
	Depth(s) Groundwater Encountered 1. ft. 2. ft. 3. ft.
	WELL'S STATIC WATER LEVEL 40 ft. below land surface measured on mo/day/yr 4-16-87
	Pump test data: Well water was ft. after hours pumping gpm
	Est. Yield 50 gpm Well water was ft. after hours pumping gpm
	Bore Hole Diameter 8 in. to 195 ft., and in. to ft.
	WELL WATER TO BE USED AS:
	5 Public water supply 8 Air conditioning 11 Injection well
	1 Domestic 3 Feedlot 6 Oil field water supply 9 Dewatering 12 Other (Specify below)
	2 Irrigation 4 Industrial 7 Lawn and garden only 10 Observation well
	Was a chemical/bacteriological sample submitted to Department? Yes.....No XX; If yes, mo/day/yr sample was submitted
	Water Well Disinfected? Yes XX No

5 TYPE OF BLANK CASING USED:	5 Wrought iron	8 Concrete tile	CASING JOINTS: Glued XX Clamped
1 Steel	3 RMP (SR)	6 Asbestos-Cement	9 Other (specify below)
2 PVC	4 ABS	7 Fiberglass	Welded
Blank casing diameter 5 in. to 195 ft., Dia			Threaded
Casing height above land surface 12 in., weight 200 psi			SDR 21
TYPE OF SCREEN OR PERFORATION MATERIAL:	7 PVC	10 Asbestos-cement	
1 Steel	3 Stainless steel	5 Fiberglass	8 RMP (SR)
2 Brass	4 Galvanized steel	6 Concrete tile	9 ABS
11 Other (specify)			12 None used (open hole)
SCREEN OR PERFORATION OPENINGS ARE:	5 Gauzed wrapped	8 Saw cut	11 None (open hole)
1 Continuous slot	3 Mill slot	6 Wire wrapped	9 Drilled holes
2 Louvered shutter	4 Key punched	7 Torch cut	10 Other (specify)
SCREEN-PERFORATED INTERVALS:	From 170 ft. to 190 ft.	From ft. to ft.	
	From ft. to ft.	From ft. to ft.	
GRAVEL PACK INTERVALS:	From 20 ft. to 195 ft.	From ft. to ft.	
	From ft. to ft.	From ft. to ft.	

6 GROUT MATERIAL:	1 Neat cement	2 Cement grout	3 Bentonite	4 Other
Grout Intervals:	From 0 ft. to 20 ft.	From ft. to ft.	From ft. to ft.	From ft. to ft.
What is the nearest source of possible contamination:	none	10 Livestock pens	14 Abandoned water well	
1 Septic tank	4 Lateral lines	7 Pit privy	11 Fuel storage	15 Oil well/Gas well
2 Sewer lines	5 Cess pool	8 Sewage lagoon	12 Fertilizer storage	16 Other (specify below)
3 Watertight sewer lines	6 Seepage pit	9 Feedyard	13 Insecticide storage	
Direction from well?		How many feet?		

FROM	TO	LITHOLOGIC LOG	FROM	TO	LITHOLOGIC LOG
0	15	Top soil & clay			
15	30	Clay			
30	45	Clay & sand rock (2 ft.)			
45	60	Clay & fine sand in layers			
60	75	Fine to medium sand (dry)			
75	90	Fine sand & clay (5 ft.)			
90	105	Clay			
105	120	Clay & fine sand (4 ft.)			
120	150	Fine sand			
150	165	Fine sand & clay			
165	180	Fine sand			
180	195	Fine to medium sand & coarse sand (very loose)			
195	210	Fine sand & clay (with white rock - Loose (5 ft.))			
210	225	Clay			
225	230	Blue shale			

7 CONTRACTOR'S OR LANDOWNER'S CERTIFICATION: This water well was (1) constructed, (2) reconstructed, or (3) plugged under my jurisdiction and was completed on (mo/day/year) 5-18-87 and this record is true to the best of my knowledge and belief. Kansas Water Well Contractor's License No. 179 This Water Well Record was completed on (mo/day/yr) May 28, 1987 under the business name of Joe's Well Service, Inc. Cimarron, Ks. by (signature) David Clark

INSTRUCTIONS: Use typewriter or ball point pen. PLEASE PRESS FIRMLY and PRINT clearly. Please fill in blanks, underline or circle the correct answers. Send top three copies to Kansas Department of Health and Environment, Bureau of Water Protection, Topeka, Kansas 66620-7320, Telephone: 913-862-9360. Send one to WATER WELL OWNER and retain one for your records.