

**WATER WELL PLUGGING RECORD Form WWC-5P KSA 82a-1212 ID NO.**


1 **LOCATION OF WATER WELL:** Fraction NL 1/4 SE 1/4 Section Number 32 Township Number 26 T 26 S Range Number ☐ E ☒ W  
 County: Ford

Street/Rural Address of Well Location; if unknown, distance & direction from nearest town or intersection: If at owner's address, check here ☐

**Global Positioning Systems (GPS) information:**  
 Latitude: \_\_\_\_\_ (in decimal degrees)  
 Longitude: \_\_\_\_\_ (in decimal degrees)  
 Elevation: \_\_\_\_\_  
 Datum: ☐ WGS84, ☐ NAD83, ☐ NAD27  
 Collection Method: ☐ GPS unit (Make/Model: \_\_\_\_\_)  
☐ Digital Map/Photo, ☐ Topographic Map, ☐ Land Survey  
 Est. Accuracy: ☐ < 3 m, ☐ 3-5 m, ☐ 5-15 m, ☐ > 15 m

2 **WATER WELL OWNER:** Circle D Farms LLC  
 RR#, St. Address, Box #: PO Box 195  
 City, State ZIP Code: Gimarron, KS 67835

3 **MARK WELL'S LOCATION WITH AN "X" IN SECTION BOX:**

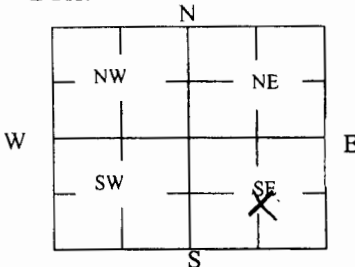

4 **DEPTH OF WELL** 125 ft.

WELL'S STATIC WATER LEVEL 117 ft

WELL WAS USED AS:

- |  |   |   |
|--|---|---|
| <input type="checkbox"/> Domestic              | <input type="checkbox"/> Public Water Supply      | <input type="checkbox"/> Dewatering     |
| <input checked="" type="checkbox"/> Irrigation | <input type="checkbox"/> Oil Field Water Supply   | <input type="checkbox"/> Monitoring     |
| <input type="checkbox"/> Feedlot               | <input type="checkbox"/> Domestic (Lawn & Garden) | <input type="checkbox"/> Injection Well |
| <input type="checkbox"/> Industrial            | <input type="checkbox"/> Air Conditioning         | <input type="checkbox"/> Other _____    |

Was a chemical/bacteriological sample submitted to Department? Yes ☐ No ☒

5 **TYPE OF BLANK CASING USED:**

- ☒ Steel ☐ RMP (SR) ☐ Wrought ☐ Fiberglass ☐ Other (Specify below) \_\_\_\_\_  
☐ PVC ☐ ABS ☐ Asbestos-Cement ☐ Concrete Tile

Blank casing diameter 16 in. Was casing pulled? Yes ☐ No ☒ If yes, how much \_\_\_\_\_  
 Casing height above or below land surface 60 in.

6 **GROUT PLUG MATERIAL:** ☐ Neat cement ☐ Cement grout ☒ Bentonite ☒ Other Quikrete

Grout Plug Intervals: From 117 ft. to 116 ft., From 9 ft. to 5 ft., From \_\_\_\_\_ to \_\_\_\_\_ ft.

What is the nearest source of possible contamination:

- |   |   |  |  |
|---|---|--|--|
| <input type="checkbox"/> Septic tank            | <input type="checkbox"/> Seepage pit    | <input type="checkbox"/> Fuel Storage                  | <input type="checkbox"/> Other (specify below) _____ |
| <input type="checkbox"/> Sewer lines            | <input type="checkbox"/> Pit privy      | <input checked="" type="checkbox"/> Fertilizer storage |  |
| <input type="checkbox"/> Watertight sewer lines | <input type="checkbox"/> Sewage lagoon  | <input type="checkbox"/> Insecticide storage           |  |
| <input type="checkbox"/> Lateral lines          | <input type="checkbox"/> Feedyard       | <input type="checkbox"/> Abandoned water well          | Direction from well? <u>N</u>                        |
| <input type="checkbox"/> Cess pool              | <input type="checkbox"/> Livestock pens | <input type="checkbox"/> Oil well/Gas well             | How many feet? <u>100</u>                            |

FROM	TO	PLUGGING MATERIALS	FROM	TO	PLUGGING MATERIALS
			<u>125</u>	<u>117</u>	<u>Gravel</u>
			<u>117</u>	<u>116</u>	<u>Bentonite</u>
			<u>116</u>	<u>9</u>	<u>Sand &amp; Clay</u>
			<u>9</u>	<u>8</u>	<u>Bentonite</u>
			<u>8</u>	<u>4 1/2</u>	<u>Quikrete</u>

7 **CONTRACTOR'S OR LANDOWNER'S CERTIFICATION:** This water well was plugged under my jurisdiction and was completed on (mo/day/year) 3-15-13 and this record is true to the best of my knowledge and belief. Kansas Water Well Contractor's License No. \_\_\_\_\_ This Water Well Record was completed on (mo/day/year) 3-15-13 under the business name of Dicks Farms by (signature) Allen R. Dicks

**INSTRUCTIONS:** Use typewriter or ballpoint pen. Please press firmly and print clearly. Please fill in blanks, underline or circle the correct answers. Send top three copies to Kansas Department of Health and Environment, Bureau of Water, Geology Section, 1000 SW Jackson St., Ste. 420, Topeka, Kansas 66612-1367. Telephone: 785/296-5524. Send one to Water Well Owner and retain one for your records. Visit us at <http://www.kdheks.gov/waterwell/index.html>.

Check one: ☒ White Copy ☐ Blue Copy ☐ Pink Copy