

1 LOCATION OF WATER WELL:	Fraction	Section Number	Township Number	Range Number
County: Gray	NW 1/4 NW 1/4 SW 1/4	20	T 26 S	R 27 E/W


Distance and direction from nearest town or city street address of well if located within city?

from Cimarron 3 1/4 miles south on Hwy. 23, 2 1/4 miles east, then 1 1/2 south

2 WATER WELL OWNER: Steve Shinogle
RR#, St. Address, Box #: P.O. Box 363
City, State, ZIP Code: Cimarron, KS 67835

Board of Agriculture, Division of Water Resources
Application Number:

3 LOCATE WELL'S LOCATION WITH AN "X" IN SECTION BOX:

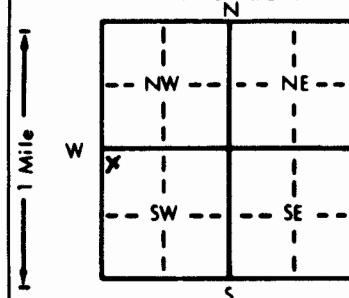

4 DEPTH OF COMPLETED WELL: 215 ft. ELEVATION:

Depth(s) Groundwater Encountered 1. ft. 2. ft. 3. ft.

WELL'S STATIC WATER LEVEL: 79' ft. below land surface measured on mo/day/yr: 2-8-76

Pump test data: Well water was ft. after hours pumping gpm

Est. Yield gpm: Well water was ft. after hours pumping gpm

Bore Hole Diameter: 9 1/8 in. to ft. and in. to ft.

WELL WATER TO BE USED AS: 5 Public water supply 8 Air conditioning 11 Injection well

6 Domestic 3 Feedlot 6 Oil field water supply 9 Dewatering 12 Other (Specify below)

2 Irrigation 4 Industrial 7 Lawn and garden only 10 Monitoring well

Was a chemical/bacteriological sample submitted to Department? Yes No If yes, mo/day/yr sample was submitted

Water Well Disinfected? Yes No

5 TYPE OF BLANK CASING USED:

1 Steel 3 RMP (SR)
2 PVC 4 ABS

5 Wrought iron

6 Asbestos-Cement
7 Fiberglass

8 Concrete tile

9 Other (specify below)

CASING JOINTS: Glued

Clamped

Welded

Threaded

Blank casing diameter in. to 215 ft., Dia. in. to ft., Dia. in. to ft.

Casing height above land surface 12 in., weight lbs./ft. Wall thickness or gauge No. 50.821

TYPE OF SCREEN OR PERFORATION MATERIAL:

1 Steel 3 Stainless steel
2 Brass 4 Galvanized steel

5 Fiberglass
6 Concrete tile

7 Gauzed wrapped
8 RMP (SR)
9 ABS

7 PVC

10 Asbestos-cement

11 Other (specify)

12 None used (open hole)

SCREEN OR PERFORATION OPENINGS ARE:

1 Continuous slot 3 Mill slot
2 Louvered shutter 4 Key punched

6 Wire wrapped

7 Torch cut

5 Gauzed wrapped

8 Saw cut
9 Drilled holes

10 Other (specify)

11 None (open hole)

SCREEN-PERFORATED INTERVALS: From 205 ft. to 215 ft., From ft. to ft. ft.

From ft. to ft., From ft. to ft. ft.

GRAVEL PACK INTERVALS: From 24 ft. to 130 ft., From 135 ft. to 225 ft.

From ft. to ft., From ft. to ft. ft.

6 GROUT MATERIAL: 1 Neat cement 2 Cement grout 3 Bentonite 4 Other

Grout Intervals: From 4 ft. to 24 ft., From 130 ft. to 135 ft., From ft. to ft.

What is the nearest source of possible contamination:

1 Septic tank 4 Lateral lines 7 Pit privy
2 Sewer line 5 Cess pool 8 Sewage lagoon
3 Watertight sewer lines 6 Seepage pit 9 Feedyard

10 Livestock pens

14 Abandoned water well

11 Fuel storage

15 Oil well/Gas well

12 Fertilizer storage

16 Other (specify below)

13 Insecticide storage

Direction from well? South How many feet? 50

FROM TO LITHOLOGIC LOG FROM TO PLUGGING INTERVALS

0	1	Topsoil	0	1	
1	28	Brown clay	1	28	
28	38	med. Sand	28	38	
38	36	Brown clay	38	36	
36	45	Med. Sand	36	45	
45	60	Brown Sandy clay	45	60	
60	104	Med. Sand	60	104	
104	106	Brown clay	104	106	
106	118	Med. sand & brown clay layers	106	118	
118	124	Brown clay	118	124	
124	130	Med. Sand	124	130	
130	136	Brown clay	130	136	
136	140	Fine sand & sandrock ledge	136	140	
140	225	Med. Sand	140	225	
225		Limestone shale	225		

7 CONTRACTOR'S OR LANDOWNER'S CERTIFICATION: This water well was (1) constructed, (2) reconstructed, or (3) plugged under my jurisdiction and was completed on (mo/day/year) 2-8-76 and this record is true to the best of my knowledge and belief. Kansas

Water Well Contractor's License No. 533 This Water Well Record was completed on (mo/day/yr) 3-11-86
under the business name of Jantzen Water Well Repair by (signature)