

1 LOCATION OF WATER WELL:	Fraction	Section Number	Township Number	Range Number
County: <u>Gray</u>	<u>NE 1/4</u>	<u>SW 1/4</u>	<u>26</u>	<u>T 26 S R 27 E</u>

Distance and direction from nearest town or city street address of well if located within city?

From Howell, 1/2 mile south to river rd, then 3 miles west. 1/2 mile east.


2 WATER WELL OWNER: Lon Nichols

RR#, St. Address, Box #: 24305 Q Rd

City, State, ZIP Code: Concordia, Ks 67335

Board of Agriculture, Division of Water Resources
Application Number:

3 LOCATE WELL'S LOCATION WITH AN "X" IN SECTION BOX:

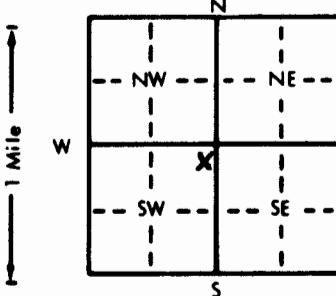

4 DEPTH OF COMPLETED WELL..... ft. ELEVATION:

Depth(s) Groundwater Encountered 1..... ft. 2..... ft. 3..... ft.

WELL'S STATIC WATER LEVEL 74' ft. below land surface measured on mo/day/yr 4-2-96

Pump test data: Well water was ft. after hours pumping gpm

Est. Yield gpm Well water was ft. after hours pumping gpm

Bore Hole Diameter 9 1/8 in. to 245' ft., and in. to ft.

WELL WATER TO BE USED AS: 5 Public water supply 8 Air conditioning 11 Injection well

1 Domestic 3 Feedlot 6 Oil field water supply 9 Dewatering 12 Other (Specify below)

2 Irrigation 4 Industrial 7 Lawn and garden only 10 Monitoring well

Was a chemical/bacteriological sample submitted to Department? Yes..... No If yes, mo/day/yr sample was submitted

Water Well Disinfected? Yes No

5 TYPE OF BLANK CASING USED:

1 Steel 3 RMP (SR)
 2 PVC 4 ABS

5 Wrought iron

6 Asbestos-Cement
7 Fiberglass

8 Concrete tile

9 Other (specify below)

CASING JOINTS: Glued Clamped

Welded

Threaded

Blank casing diameter 5 in. to 225 ft., Dia in. to ft., Dia in. to ft.

Casing height above land surface lbs./ft. Wall thickness or gauge No. SDR 21

TYPE OF SCREEN OR PERFORATION MATERIAL:

1 Steel 3 Stainless steel
2 Brass 4 Galvanized steel

5 Fiberglass
6 Concrete tile

7 PVC
8 RMP (SR)
9 ABS

5 Gauzed wrapped

6 Wire wrapped

7 Torch cut

10 Asbestos-cement

11 Other (specify)

12 None used (open hole)

13 Saw cut

9 Drilled holes

10 Other (specify)

11 None (open hole)

SCREEN OR PERFORATION OPENINGS ARE:

1 Continuous slot 3 Mill slot
2 Louvered shutter 4 Key punched

5 Gauzed wrapped

6 Wire wrapped

7 Torch cut




SCREEN-PERFORATED INTERVALS: From 225 ft. to 245 ft. From ft. to ft.

From ft. to ft. From ft. to ft.

GRAVEL PACK INTERVALS: From 245' ft. to 150 ft. From ft. to 155 ft. From ft. to 245 ft.

From ft. to ft. From ft. to ft.

6 GROUT MATERIAL: 1 Neat cement 2 Cement grout 3 Bentonite 4 Other

GROUT INTERVALS: From 4 ft. to 24 ft., From 130 ft. to 155 ft., From ft. to ft.

What is the nearest source of possible contamination:

1 Septic tank 4 Lateral lines
2 Sewer lines 5 Cess pool
3 Watertight sewer lines 6 Seepage pit

7 Pit privy
8 Sewage lagoon
9 Feedyard

10 Livestock pens

11 Fuel storage

12 Fertilizer storage

13 Insecticide storage

14 Abandoned water well

15 Oil well/Gas well

16 Other (specify below)

Direction from well?

Southwest

How many feet? 20'

7 CONTRACTOR'S OR LANDOWNER'S CERTIFICATION: This water well was constructed, (2) reconstructed, or (3) plugged under my jurisdiction and was completed on (mo/day/year) 4-2-96 and this record is true to the best of my knowledge and belief. Kansas

Water Well Contractor's License No. 533 This Water Well Record was completed on (mo/day/yr) 6-6-96 by (signature) [Signature]

under the business name of Janzen Water Well Service