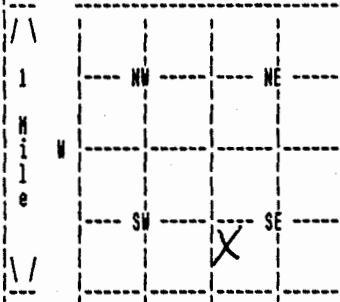


## WATER WELL RECORD Form WWC-5 KSA 82a-1212

1 LOCATION OF WATER WELL: COUNTY: GRAFT	Fraction NW 1/4 SW 1/4 SE 1/4	Section Number 9	Township Number T 26 S	Range Number R 27 E
--	----------------------------------	---------------------	---------------------------	------------------------

Distance and direction from nearest town or city street address of well if located within city?  
FROM CIMARRON - 3 1/2 EAST ON HIGHWAY 50

2 WATER WELL OWNER: RR#, St. Address, Box #: BOX 1027 City, State, ZIP code : DODGE CITY, KS 67801	KINDSVATER, DENNIS Board of Agriculture, Division of Water Resources Application Number:
--	--

3 LOCATE WELL'S LOCATION WITH AN "X" IN SECTION BOX:	4 DEPTH OF COMPLETED WELL 165 ELEVATION: 0 Depth(s) Groundwater Encountered 1. 0 ft. 2. 0 ft. 3. 0 ft.
	WELL'S STATIC WATER LEVEL 23 ft. below land surface measured on mo/day/yr 11/04/96 Pump testdata: Well water was 0 ft. after 0 hours pumping 0 gpm Estimated Yield 80 gpm: Well water was 0 ft. after 0 hours pumping 0 gpm Bore Hole Diameter 9 in. to 165 ft., and in. to 0 ft. WELL WATER TO BE USED AS: DOMESTIC Was a chemical/bacteriological sample submitted to department? No; If yes, mo/day/yr sample was submitted Water well disinfected? Yes

5 TYPE OF BLANK CASING USED: PVC	CASING JOINTS: GLUED
Blank casing diameter 5 in. to 165 ft., Dia in. to 0 ft., Dia in. to 0 ft.	
Casing height above land surface 12 in., weight 200 lbs/ft. Wall thickness or gauge No. 21	
TYPE OF SCREEN OR PERFORATION MATERIAL: PVC	
SCREEN OR PERFORATION OPENINGS ARE: SAW CUT	

SCREEN PERFORATED INTERVALS:	From 140 ft. to 160 ft., From 0 ft. to 0 ft.
GRAVEL PACK INTERVALS:	From 0 ft. to 0 ft., From 0 ft. to 0 ft.

6 GROUT MATERIAL BENTONITE	
Grout Intervals: From 0 ft. to 33 ft., From 0 ft. to 0 ft., From 0 ft. to 0 ft.	
What is the nearest source of possible contamination: NONE - NEW SITE	
Direction from well?	How many feet? 0

FROM	TO	LITHOLOGIC LOG	FROM	TO	PLUGGING INTERVALS
0	20	TOPSOIL CLAY FINE SAND			
20	40	FINE SAND CLAY IN LAYERS			
40	80	MEDIUM SAND CLAY LAYERS			
80	120	CLAY TAN IN COLOR			
120	140	FINE - MED SAND			
140	160	MED-COARSE SAND SMALL GRAVEL			
160	180	CLAY ROCK LAYERS BLUE SHALE			

7 CONTRACTOR'S OR LANDOWNER'S CERTIFICATION: This water well was Constructed under my jurisdiction and was completed on (mo/day/year) 01/12/97 and this record is true to the best of my knowledge and belief. Kansas Water Well Contractor's License No. 179 This Water Well Record was completed on (mo/day/yr) 01/10/97 under the business name of JOE'S WELL SERVICE, INC.	by (signature) <i>Joseph Cusk</i>
--	-----------------------------------