

LOCATION OF WATER WELL:	Fraction	Section Number	Township Number	Range Number
County: Gray	SW 1/4 SW 1/4 SE 1/4	8	T 26 S	R 27 E

Distance and direction from nearest town or city street address of well if located within city?

From Cimarron, Kansas on highway 50 - 2 miles East

WATER WELL OWNER: R. L. Salmons


RR#, St. Address, Box # :

City, State, ZIP Code : Cimarron, Kansas 67835

Board of Agriculture, Division of Water Resources

Application Number:

LOCATE WELL'S LOCATION WITH AN "X" IN SECTION BOX:

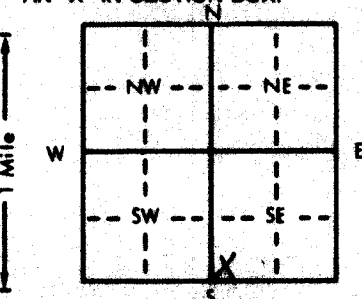

DEPTH OF COMPLETED WELL: 165 ft. ELEVATION:

Depth(s) Groundwater Encountered 1. ft. 2. ft. 3. ft.
WELL'S STATIC WATER LEVEL 34 ft. below land surface measured on mo/day/yr May 6, 1985

Pump test data: Well water was ft. after hours pumping gpm

Est. Yield 65 gpm: Well water was ft. after hours pumping gpm

Bore Hole Diameter 8 in. to 165 ft., and in. to ft.

WELL WATER TO BE USED AS: 5 Public water supply 8 Air conditioning 11 Injection well

1 Domestic 3 Feedlot 6 Oil field water supply 9 Dewatering 12 Other (Specify below)

2 Irrigation 4 Industrial 7 Lawn and garden only 10 Observation well

Was a chemical/bacteriological sample submitted to Department? Yes No XXX; If yes, mo/day/yr sample was submitted
Water Well Disinfected? Yes XXX No

TYPE OF BLANK CASING USED:

1 Steel 3 RMP (SR)

2 PVC 4 ABS

5 Wrought iron

6 Asbestos-Cement

7 Fiberglass

8 Concrete tile

9 Other (specify below)

CASING JOINTS: Glued XX Clamped

Welded

Threaded

Blank casing diameter 5 in. to 165 ft., Dia in. to ft., Dia in. to ft.

Casing height above land surface 12 in., weight 200 psi lbs./ft. Wall thickness or gauge No. SDR 21

TYPE OF SCREEN OR PERFORATION MATERIAL:

1 Steel 3 Stainless steel

2 Brass 4 Galvanized steel

5 Fiberglass

6 Concrete tile

7 PVC

8 RMP (SR)

9 ABS

10 Asbestos-cement

11 Other (specify)

12 None used (open hole)

SCREEN OR PERFORATION OPENINGS ARE:

1 Continuous slot

2 Louvered shutter

3 Mill slot

4 Key punched

5 Gauzed wrapped

6 Wire wrapped

7 Torch cut

8 Saw cut

9 Drilled holes

10 Other (specify)

11 None (open hole)

SCREEN-PERFORATED INTERVALS: From 140 ft. to 160 ft., From ft. to ft.

From ft. to ft., From ft. to ft.

GRAVEL PACK INTERVALS: From 37 ft. to 165 ft., From ft. to ft.

From ft. to ft., From ft. to ft.

GROUT MATERIAL:

1 Neat cement

2 Cement grout

3 Bentonite

4 Other

Grout intervals: From 6 ft. to 37 ft., From ft. to ft., From ft. to ft.

What is the nearest source of possible contamination:

1 Septic tank

2 Sewer lines

3 Watertight sewer lines 6 Seepage pit

4 Lateral lines

5 Cess pool

6 Seepage pit

7 Pit privy

8 Sewage lagoon

9 Feedyard

10 Livestock pens

11 Fuel storage

12 Fertilizer storage

13 Insecticide storage

14 Abandoned water well

15 Oil well/Gas well

16 Other (specify below)

Direction from well? East

How many feet? 75

FROM	TO	LITHOLOGIC LOG	FROM	TO	LITHOLOGIC LOG
0	15	Top soil, corase sand & gravel			
15	30	Coarse sand & gravel			
30	45	Coarse sand & gravel, clay (5 ft.)			
45	60	Clay			
60	75	Clay, fine sand in layers			
75	90	" " " "			
90	105	Clay			
105	120	Clay & fine sand (2 ft.)			
120	150	Fine to medium sand & some coarse sand			
150	160	Medium to coarse sand (very loose)			
160	165	Rock layers & clay			

CONTRACTOR'S OR LANDOWNER'S CERTIFICATION: This water well was (1) constructed, (2) reconstructed, or (3) plugged under my jurisdiction and was completed on (mo/day/year) May 7, 1985 and this record is true to the best of my knowledge and belief. Kansas

Water Well Contractor's License No. 179 This Water Well Record was completed on (mo/day/yr) May 31, 1985

under the business name of Joe's Well Service, Inc. Cimarron, Kansas

INSTRUCTIONS: Use typewriter or ball point pen, PLEASE PRESS FIRMLY and PRINT clearly. Please fill in blanks, underline or circle the correct answers. Send top three copies to Kansas Department of Health and Environment, Division of Environment, Environmental Geology Section, Topeka, KS 66620. Send one to WATER WELL OWNER and retain one for your records.