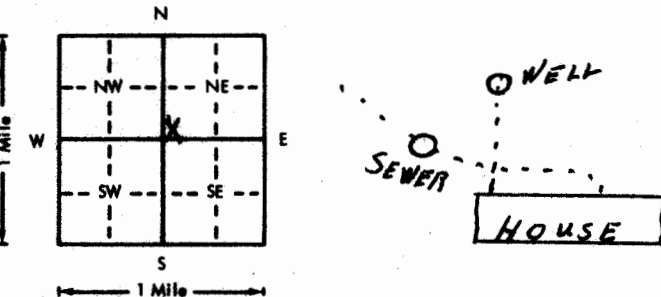


USE TYPEWRITER OR BALL
POINT PEN-PRESS FIRMLY,
PRINT CLEARLY.

WATER WELL RECORD
KSA 82a-1201-1215

Kansas Department of Health and
Environment-Division of Environment
(Water well Contractors)
Topeka, Kansas 66620

1. Location of well:	County Gray	Fraction NW 1/4 SW 1/4 NE 1/4	Section number #8	Township number T #26	Range number S R #27
2. Distance and direction from nearest town or city: 3 miles east on Highway 50 of Cimarron, Ks. Street address of well location if in city:			3. Owner of well: R. L. Simons R.R. or street: R.R. City, state, zip code: Cimarron, Kansas 67835		
4. Locate with "X" in section below: 			6. Bore hole dia. 5 in. Completion date 7-26-76 Well depth 190 ft.		
			7. Cable tool ☒ Rotary ☐ Driven ☐ Dug ☐ Hollow rod ☐ Jetted ☐ Bored ☐ Reverse rotary		
			8. Use: ☒ Domestic ☐ Public supply ☐ Industry ☐ Irrigation ☐ Air conditioning ☐ Stock ☐ Lawn ☐ Oil field water ☐ Other		
			9. Casing: Material RMP Height: Above or below 12 in. Threaded ☐ Welded ☐ Surface 12 in. RMP ☒ PVC ☐ Weight 125 lbs./ft. Dia. 5 in. to 190 ft. depth Well Thickness: inches or Dia. 5 in. to 190 ft. depth gage No. 250		
5. Type and color of material			From	To	10. Screen: Manufacturer's name Burflow
Top soil & clay			0	15	Type RMP Dia. 5"
Clay			15	30	Slope 1/4" Length 20 ft.
Clay & fine sand			30	45	Set between 165 ft. and 185 ft.
Clay			45	75	Gravel pack? YES Size range of material 1"
Clay & fine sand mixed			75	90	11. Static water level: 110 ft. below land surface Date 7-26-76
Clay & fine sand layers			90	105	12. Pumping level below land surfaces: 110 ft. after 1 hrs. pumping 50 g.p.m. 110 ft. after 1 hrs. pumping 50 g.p.m.
Fine sand			105	135	Estimated maximum yield 70 g.p.m.
Fine sand & clay layers			135	150	13. Water sample submitted: YES No NO Date 7-26-76
Fine to medium sand			150	165	14. Well head completion: X Pitless adapter 212 inches above grade
Medium to coarse sand			165	180	15. Well grouted? YES With: X Neat cement ☐ Bentonite ☐ Concrete ☐ Depth From 7 ft. to 17 ft.
Coarse sand, clay & blue shale			180	190	16. Nearest source of possible contamination: NO Direction NW Type Sewer Well disinfected upon completion? YES Yes ☐ No ☐
					17. Pump: X Not installed Manufacturer's name _____ Model number _____ HP _____ Volts _____ Length of drop pipe _____ ft. capacity _____ g.p.m. Type: _____ ☐ Submersible ☐ Turbine ☐ Jet ☐ Reciprocating ☐ Centrifugal ☐ Other
18. Elevation:			19. Remarks: Has excellent drainage to the West		
Topography: ☒ Hill ☐ Slope ☐ Upland ☐ Valley			20. Water well contractor's certification: This well was drilled under my jurisdiction and this report is true to the best of my knowledge and belief. Joe's Well Service 179 Business name License No. Address Box 174 Cimarron, Ks. Signed Long Craig 6-27-76 Authorized representative Date		

Forward the white, blue and pink copies to the Department of Health and Environment

Form WWC-5