USE TYPEWRITER OR BALL POINT PEN-PRESS FIRMLY, PRINT CLEARLY.

WATER WELL RECORD
KSA 82a-1201-1215

Kansas Department of Health and Environment-Division of Environment
(Water well Contractors)
Topeka, Kansas 66620

1. Location of well:	County	Fraction	Section number	Township number	Range number
	Gray	SE 1/4 NE 1/4 SW 1/4	#11	T #26 S	R #27 W

2. Distance and direction from nearest town or city: 6 miles east of Cimarron on Highway 50
Street address of well location if in city:

3. Owner of well: Gerald Longton
R.R. or street: Route #2
City, state, zip code: Dodge City, Kansas 67801

4. Locate with "X" in section below:

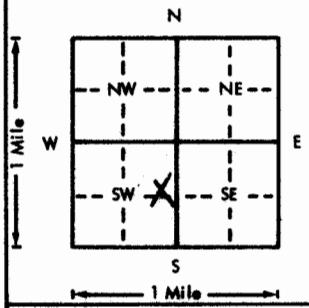

Sketch map:

6. Bore hole dia. 8 in. Completion date 9-14-75
Well depth 148 ft.

7. __ Cable tool X Rotary __ Driven __ Dug
__ Hollow rod __ Jetted __ Bored __ Reverse rotary

8. Use: X Domestic __ Public supply __ Industry
__ Irrigation __ Air conditioning __ Stock
__ Lawn __ Oil field water __ Other

9. Casing: Material RMP Height: Above or Below
Threaded ___ Welded ___ Surface 12 in.
RMP X PVC ___ Weight ___ lbs./ft.
Dia. 5 in. to 148 ft. depth Wall Thickness: inches or
Dia. ___ in. to ___ ft. depth gage No. 250

5. Type and color of material	From	To
(Use a second sheet if needed)		

10. Screen: Manufacturer's name Jess & Lowell
Type RMP Dia. 5"
Slot/gauze 1/8" Length 20 ft.
Set between 125 ft. and 145 ft.
___ ft. and ___ ft.
Gravel pack? yes Size range of material 2"

11. Static water level: mo./day/yr.
63 ft. below land surface Date 9-14-75

12. Pumping level below land surfaces:
___ ft. after ___ hrs. pumping ___ g.p.m.
___ ft. after ___ hrs. pumping ___ g.p.m.
Estimated maximum yield ___ g.p.m.

13. Water sample submitted: mo./day/yr.
___ Yes X No Date

14. Well head completion: None
___ Pitless adapter ___ inches above grade

15. Well grouted? yes
With: ___ Neat cement X Bentonite ___ Concrete
Depth: From 0 ft. to 10 ft.

16. Nearest source of possible contamination: None
ft. ___ Direction ___ Type ___
Well disinfected upon completion? X Yes ___ No

17. Pump: Windmill X Not installed
Manufacturer's name
Model number ___ HP ___ Volts ___
Length of drop pipe ___ ft. capacity ___ g.p.m.
Type:
___ Submersible ___ Turbine
___ Jet ___ Reciprocating
___ Centrifugal ___ Other

18. Elevation:

Topography:
___ Hill
X Slope
___ Upland
___ Valley

19. Remarks:

20. Water well contractor's certification:
This well was drilled under my jurisdiction and this report is true to the best of my knowledge and belief.
JOE'S WELL SERVICE 179
Business name License No.
Address Box 174 Cimarron, Ks.
Signed Larry Crick Date 12-29-75
Authorized representative

T 26 R 27 Sec 11 1/4 SE 1/4 NE 1/4 SW

Forward the white, blue and pink copies to the Department of Health and Environment

Form WWC-5

M1-1083