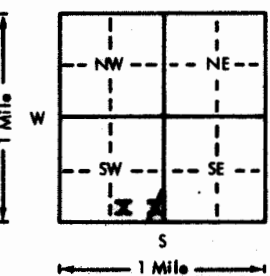
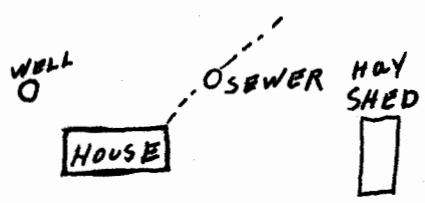


USE TYPEWRITER OR BALL
POINT PEN-PRESS FIRMLY,
PRINT CLEARLY.

WATER WELL RECORD
KSA 82a-1201-1215

Kansas Department of Health and
Environment-Division of Environment
(Water well Contractors)
Topeka, Kansas 66620

Location

☒ Location of well:	County Gray	Fraction SW 1/4 SE 1/4 SW 1/4	Section number 14	Township number T #26	Range number S R #27 E2W
☒ Distance and direction from nearest town or city: 1 mile south and 6 miles east of Cimarron, Ks.	3. Owner of well: John Jillins R.R. or street: Route #1 City, state, zip code: Cimarron, Kansas 67835				
4. Locate with "X" in section below: 		Sketch map: 			
5. Type and color of material		From	To	6. Bore hole dia. 5 in. Completion date 11-6-75 Well depth 205 ft.	
Top soil & coarse sand		0	15	7. Cable tool ☒ Rotary ☐ Driven ☐ Dug Hollow rod ☐ Jetted ☐ Bored ☐ Reverse rotary	
Coarse sand		15	30	8. Use: ☒ Domestic ☐ Public supply ☐ Industry ☐ Irrigation ☐ Air conditioning ☐ Stock ☐ Lawn ☐ Oil field water ☐ Other	
Coarse sand & clay		30	45	9. Casings: Material RMP Height: Above or BELOW Threaded ☐ Welded ☐ Surface 12 in. RMP ☒ PVC ☐ Weight ☐ lbs./ft. Dia. 5 in. to 205 ft. depth Well thickness: inches or Dia. ☐ in. to ☐ ft. depth gage No. 250	
Clay		45	60	10. Screen: Manufacturer's name SHAWMUT Type RMP Dia. 5 in. Slot/gauze 1/8 in. Length 20 ft. Set between 180 ft. and 200 ft. ft. and ☐ ft. Gravel pack YES Size range of material 1/4 in.	
Clay & fine to medium sand		60	75	11. Static water level: 15 ft. below land surface Date 11-6-75 mo./day/yr.	
Medium sand		75	90	12. Pumping level below land surfaces: 20 ft. after 2 hrs. pumping 60 g.p.m. ft. after ☐ hrs. pumping ☐ g.p.m. Estimated maximum yield 100 g.p.m.	
Medium to coarse sand & rock layers		90	105	13. Water sample submitted: ☐ Yes ☒ No Date ☐	
Fine to medium sand		105	150	14. Well head completion: ☒ Pitless adapter 12 inches above grade	
Medium to coarse sand		150	180	15. Well grouted? yes With: ☒ Neat cement ☐ Bentonite ☐ Concrete Depth: From 4 ft. to 15 ft.	
Coarse sand		180	195	16. Nearest source of possible contamination: ft. 100 Direction east Type sewer Well disinfected upon completion? ☒ Yes ☐ No	
Coarse sand & clay		195	210	17. Pump: ☒ Not installed Manufacturer's name ☐ Model number ☐ HP ☐ Volts ☐ Length of drop pipe ☐ ft. capacity ☐ g.p.m. Type: ☐ Submersible ☐ Turbine ☐ Jet ☐ Reciprocating ☐ Centrifugal ☐ Other	
18. Elevation:		20. Water well contractor's certification: This well was drilled under my jurisdiction and this report is true to the best of my knowledge and belief. JOE'S WELL SERVICE 179 Business name License No. Address Box 174 Cimarron, Ks. Signed Larry Crick 12-20-75 Authorized representative			
19. Remarks: 					

Forward the white, blue and pink copies to the Department of Health and Environment

Form WWC-5