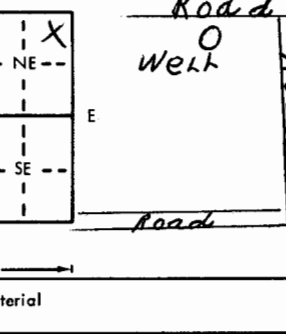


1. Location of well: Gray	County Fraction NE 1/4 NE 1/4 NE 1/4	Section number #17	Township number T #26	Range number S R #27 W
2. Distance and direction from nearest town or city: 1 mile south and 2 1/2 miles east of Cimarron, Ks. Street address of well location if in city:		3. Owner of well: Clarence Crick R.R. or street: City, state, zip code: Cimarron, Kansas 67835		
4. Locate with "X" in section below: <div style="text-align: center;">N W E S 1 Mile</div> 		Sketch map: Road Well Feeding Pen Road		
5. Type and color of material		From	To	
Top soil & coarse sand		0	15	
Coarse sand		15	30	
Clay		30	75	
Clay & fine sand		75	90	
Clay & fine sand layers		90	120	
Fine to medium sand		120	135	
Medium to coarse sand		135	150	
Coarse sand		150	180	
Coarse sand & clay (blue) shale		180	190	
(Use a second sheet if needed)				
6. Bore hole dia. 8 in. Completion date 10-22-75 Well depth 185 ft.	7. Cable tool <input checked="" type="checkbox"/> Rotary <input type="checkbox"/> Driven <input type="checkbox"/> Dug <input type="checkbox"/> Hollow rod <input type="checkbox"/> Jetted <input type="checkbox"/> Bored <input type="checkbox"/> Reverse rotary			
8. Use: <input type="checkbox"/> Domestic <input type="checkbox"/> Public supply <input type="checkbox"/> Industry <input type="checkbox"/> Irrigation <input type="checkbox"/> Air conditioning <input checked="" type="checkbox"/> Stock <input type="checkbox"/> Lawn <input type="checkbox"/> Oil field water <input type="checkbox"/> Other				
9. Casing: Material RMP Height: Above or Below Threaded <input type="checkbox"/> Welded <input type="checkbox"/> Surface 12 in. RMP <input checked="" type="checkbox"/> PVC <input type="checkbox"/> Weight _____ lbs./ft. Dia. 5 in. to 185 ft. depth Wall Thickness: inches or Dia. _____ in. to _____ ft. depth Gauge No. 250				
10. Screen: Manufacturer's name Jess & Lowell Type RMP Dia. 5" Slot/gauze 1/8" Length 20 ft. Set between 160 ft. and 180 ft. _____ ft. and _____ ft. Gravel pack? yes Size range of material 4"				
11. Static water level: _____ mo./day/yr. 15 ft. below land surface Date 10-22-75				
12. Pumping level below land surfaces: 15 ft. after 2 hrs. pumping 60 g.p.m. _____ ft. after _____ hrs. pumping _____ g.p.m. Estimated maximum yield 60 g.p.m.				
13. Water sample submitted: _____ mo./day/yr. <input type="checkbox"/> Yes <input checked="" type="checkbox"/> No Date _____				
14. Well head completion: <input checked="" type="checkbox"/> Pitless adapter 12 Inches above grade				
15. Well grouted? yes With: <input checked="" type="checkbox"/> Neat cement <input type="checkbox"/> Bentonite <input type="checkbox"/> Concrete Depth: From 5 ft. to 15 ft.				
16. Nearest source of possible contamination: Feed lot ft. 50 Direction east Type lot Well disinfected upon completion? <input checked="" type="checkbox"/> Yes <input type="checkbox"/> No				
17. Pump: Not installed Manufacturer's name Flint & Walling Model number 10BK9 HP 1 1/2 Volt 230 Length of drop pipe 117 ft. capacity 19 g.p.m. Type: <input checked="" type="checkbox"/> Submersible <input type="checkbox"/> Turbine <input type="checkbox"/> Jet <input type="checkbox"/> Reciprocating <input type="checkbox"/> Centrifugal <input type="checkbox"/> Other				
18. Elevation:		19. Remarks:		
Topography: <input type="checkbox"/> Hill <input type="checkbox"/> Slope <input checked="" type="checkbox"/> Upland <input type="checkbox"/> Valley				
20. Water well contractor's certification: This well was drilled under my jurisdiction and this report is true to the best of my knowledge and belief. JOE'S WELL SERVICE 179 Business name License No. Address Box 174 Cimarron, Kans. Signed Clarence Crick Date 12-20-75 Authorized representative				