

1 LOCATION OF WATER WELL:		Fraction County: <u>SE 1/4</u>	Section Number <u>SE 1/4</u>	Township Number <u>74</u>	Range Number <u>T 26 S R 27 E</u>
---------------------------	--	-----------------------------------	---------------------------------	------------------------------	--------------------------------------

Distance and direction from nearest town or city street address of well if located within city?

From Hawell 1 mile south, 3 1/2 miles west. 1/2 mile south


2 WATER WELL OWNER: Rocky Fairbank

RR#, St. Address, Box #: Rt. 2

City, State, ZIP Code: Cimarron, KS 67835

Board of Agriculture, Division of Water Resources
Application Number:

3 LOCATE WELL'S LOCATION WITH AN "X" IN SECTION BOX:

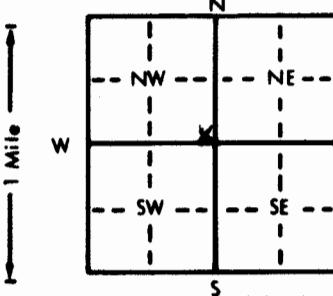

4 DEPTH OF COMPLETED WELL.....213' ft. ELEVATION:

Depth(s) Groundwater Encountered 1..... ft. 2..... ft. 3..... ft.

WELL'S STATIC WATER LEVEL.....114' ft. below land surface measured on mo/day/yr.....11-6-81

Pump test data: Well water was ft. after hours pumping gpm

Est. Yield gpm; Well water was ft. after hours pumping gpm

Bore Hole Diameter.....9 1/8 in. to ft., and in. to ft.

WELL WATER TO BE USED AS: 5 Public water supply 8 Air conditioning 11 Injection well

1 Domestic 3 Feedlot 6 Oil field water supply 9 Dewatering 12 Other (Specify below)

2 Irrigation 4 Industrial 7 Lawn and garden only 10 Monitoring well

Was a chemical/bacteriological sample submitted to Department? Yes.....No.....X; If yes, mo/day/yr sample was submitted

Water Well Disinfected? Yes X No

5 TYPE OF BLANK CASING USED:

1 Steel 3 RMP (SR)
2 PVC 4 ABS

5 Wrought iron

8 Concrete tile

CASING JOINTS: Glued X Clamped

Welded

Threaded.

Blank casing diameter.....

5" in. to193' ft., Dia..... in. to ft., Dia..... in. to ft.

Casing height above land surface.....24' in., weight

lbs./ft. Wall thickness or gauge No.SPR 15.....

TYPE OF SCREEN OR PERFORATION MATERIAL:

1 Steel 3 Stainless steel
2 Brass 4 Galvanized steel

5 Fiberglass

7 PVC

8 RMP (SR)

10 Asbestos-cement

11 Other (specify)

6 Concrete tile

9 ABS

12 None used (open hole)

SCREEN OR PERFORATION OPENINGS ARE:

1 Continuous slot 3 Mill slot
2 Louvered shutter 4 Key punched

5 Gauzed wrapped

6 Wire wrapped

7 Torch cut

8 Saw cut

9 Drilled holes

10 Other (specify)

SCREEN-PERFORATED INTERVALS: From.....193' ft. to213' ft., From..... ft. to ft.

From..... ft. to ft., From..... ft. to ft.

GRAVEL PACK INTERVALS: From.....20 ft. to110 ft., From.....125 ft. to213 ft.

From..... ft. to ft., From..... ft. to ft.

6 GROUT MATERIAL:

1 Neat cement 2 Cement grout

3 Bentonite

4 Other

Grout Intervals: From.....0 ft. to20 ft., From.....110 ft. to125 ft., From..... ft. to ft.

What is the nearest source of possible contamination:

1 Septic tank 4 Lateral lines 7 Pit privy
2 Sewer lines 5 Cess pool 8 Sewage lagoon
3 Watertight sewer lines 6 Seepage pit 9 Feedyard

10 Livestock pens

11 Fuel storage

12 Fertilizer storage

13 Insecticide storage

14 Abandoned water well

15 Oil well/Gas well

16 Other (specify below)

Direction from well?

west

How many feet? 12

7 CONTRACTOR'S OR LANDOWNER'S CERTIFICATION: This water well was (1) constructed, (2) reconstructed, or (3) plugged under my jurisdiction and was completed on (mo/day/year).....11-19-81..... and this record is true to the best of my knowledge and belief. Kansas

Water Well Contractor's License No.533..... This Water Well Record was completed on (mo/day/yr).....12-19-81.....

under the business name of Tanton Water Well Repair by (signature) John Tanton