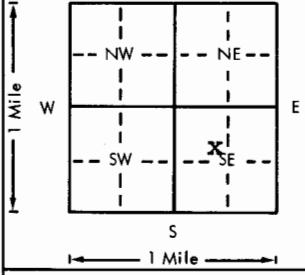


USE TYPEWRITER OR BALL
POINT PEN-PRESS FIRMLY,
PRINT CLEARLY

WATER WELL RECORD
KSA 82a-1201-1215

Kansas Department of Health and
Environment-Division of Environment
(Water well Contractors)
Topeka, Kansas 66620

1. Location of well:	County Gray	Fraction SE 1/4 NW 1/4 SE 1/4	Section number 29	Township number T 26	Range number S 27	W	
2. Distance and direction from nearest town or city:	3 south, 3 east, 1/2 north, 1/4 northwest		3. Owner of well: R.R. or street: City, state, zip code:	Louis Beery 106 N. 1st. Cimarron, Ks. 67835			
4. Locate with "X" in section below:	Sketch map: 		6. Bore hole dia. 26 in. Completion date 10-10-76 Well depth 240 ft.				
5. Type and color of material			From	To	7. <input type="checkbox"/> Cable tool <input type="checkbox"/> Rotary <input type="checkbox"/> Driven <input type="checkbox"/> Dug <input type="checkbox"/> Hollow rod <input type="checkbox"/> Jetted <input type="checkbox"/> Bored <input checked="" type="checkbox"/> Reverse rotary		
					8. Use: <input type="checkbox"/> Domestic <input type="checkbox"/> Public supply <input type="checkbox"/> Industry <input checked="" type="checkbox"/> Irrigation <input type="checkbox"/> Air conditioning <input type="checkbox"/> Stock <input type="checkbox"/> Lawn <input type="checkbox"/> Oil field water <input type="checkbox"/> Other		
					9. Casing: Material <input type="checkbox"/> Steel <input type="checkbox"/> Height: Above <input type="checkbox"/> <input type="checkbox"/> Threaded <input type="checkbox"/> Welded <input checked="" type="checkbox"/> Surface 12 in. RMP <input type="checkbox"/> PVC <input type="checkbox"/> Weight 36.87 lbs./ft. Dia. 16 in. to 241 ft. depth Wall Thickness: inches or Dia. <input type="checkbox"/> in. to <input type="checkbox"/> ft. depth gage No. 250		
					10. Screen: Manufacturer's name <input type="checkbox"/> Johnson Type galv. Dia. 16" Slot/gauge <input type="checkbox"/> Length 20 ft. Set between 210 ft. and 230 ft. Perf: 80-210 ft. and 230-240 ft. Gravel pack? <input checked="" type="checkbox"/> Yes Size range of material 2" down		
					11. Static water level: <input type="checkbox"/> mo./day/yr. 48 ft. below land surface Date 9-23-76		
					12. Pumping level below land surfaces: 60 ft. after 3 hrs. pumping 1550 g.p.m. <input type="checkbox"/> ft. after <input type="checkbox"/> hrs. pumping <input type="checkbox"/> g.p.m. Estimated maximum yield 1550 g.p.m.		
					13. Water sample submitted: <input type="checkbox"/> mo./day/yr. Yes <input checked="" type="checkbox"/> No Date		
					14. Well head completion: <input type="checkbox"/> Pitless adapter 12 inches above grade		
					15. Well grouted? <input checked="" type="checkbox"/> With: <input type="checkbox"/> Neat cement <input type="checkbox"/> Bentonite <input checked="" type="checkbox"/> Concrete Depth: From 0 ft. to 10 ft.		
					16. Nearest source of possible contamination: N/A ft. <input type="checkbox"/> Direction <input type="checkbox"/> Type <input type="checkbox"/> Well disinfected upon completion? <input type="checkbox"/> Yes <input checked="" type="checkbox"/> No		
					17. Pump: <input type="checkbox"/> Not installed Manufacturer's name Goulds-US Pump Model number 12JHC HP 100 Volts <input type="checkbox"/> Length of drop pipe 160 ft. capacity 1200 g.p.m. Type: <input type="checkbox"/> Submersible <input checked="" type="checkbox"/> Turbine <input type="checkbox"/> Jet <input type="checkbox"/> Reciprocating <input type="checkbox"/> Centrifugal <input type="checkbox"/> Other		
(Use a second sheet if needed)		20. Water well contractor's certification: This well was drilled under my jurisdiction and this report is true to the best of my knowledge and belief. Minter-Wilson Drilg. Co. 208 Business name <input type="checkbox"/> License No. <input type="checkbox"/> Address <input type="checkbox"/> Box A Garden City, Ks. Signed <input type="checkbox"/> Date 5-13-76 Authorized representative <input type="checkbox"/>					
18. Elevation:	19. Remarks:						
Topography: <input type="checkbox"/> Hill <input checked="" type="checkbox"/> Slope <input type="checkbox"/> Upland <input type="checkbox"/> Valley							

92
MINTER-WILSON DRILLING CO. INCORPORATED

Irrigation
and Domestic
Water Systems
Complete Installation
and Repairing

Phone 276-8269 • P.O. Box 493 • GARDEN CITY, KANSAS 67846

LOUIS BEALY
WIAW COUNTY
7-7-76

Location: SE 1/4 29-26-27 South West corner of Quarter
Static Water Level- 50'

Test #

0	2	Top soil
2	17	Brown clay
17	144	Fine to med. sand and gravel
144	178	Brown clay
178	237	Fine to med. sand and gravel
237	240	Shale

P.O. 240
Screen 20