


## WATER WELL RECORD Form WWC-5 KSA 82a-1212

1 LOCATION OF WATER WELL: COUNTY: GRAY	Fraction SB 1/4 SE 1/4 NE 1/4	Section Number 30	Township Number T 26 S	Range Number R 27 W
---	----------------------------------	----------------------	---------------------------	------------------------

Distance and direction from nearest town or city street address of well if located within city?  
FROM CINARROW - 4 MILES SOUTH ON HIGHWAY 23 2 M EAST & 1/2 N

2 WATER WELL OWNER: CARL LEATHERWOOD  
RR#, St. Address, Box #: \_\_\_\_\_  
City, State, ZIP code : CINARROW, KS 67835-  
Board of Agriculture, Division of Water Resources  
Application Number:

3 LOCATE WELL'S LOCATION WITH  
AN "X" IN SECTION BOX:

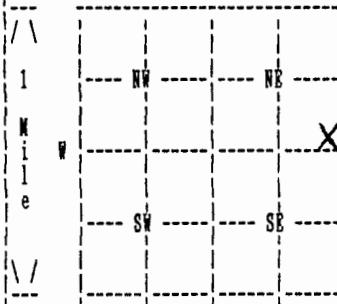

4 DEPTH OF COMPLETED WELL 265 ELEVATION: 0  
Depth(s) Groundwater Encountered 1. 0 ft. 2. 0 ft. 3. 0 ft.

WELL'S STATIC WATER LEVEL 120 ft. below land surface measured on mo/day/yr 09/17/92  
Pump testdata: Well water was 0 ft. after 0 hours pumping 0 gpm

Estimated Yield 80 gpm: Well water was 0 ft. after 0 hours pumping 0 gpm

Bore Hole Diameter 8 in. to 265 ft., and in. to 0 ft.

WELL WATER TO BE USED AS: DOMESTIC

Was a chemical/bacteriological sample submitted to department? No;  
If yes, mo/day/yr sample was submitted Water well disinfected? Yes

5 TYPE OF BLANK CASING USED: PVC CASING JOINTS: GLUED

Blank casing diameter 5 in. to 265 ft., Dia in. to 0 ft., Dia in. to 0 ft.

Casing height above land surface 12 in., weight 200 lbs/ft. Wall thickness or gauge No. 21

TYPE OF SCREEN OR PERFORATION MATERIAL: PVC

SCREEN OR PERFORATION OPENINGS ARE: SAW CUT

SCREEN PERFORATED INTERVALS: From 220 ft. to 260 ft., From 0 ft. to 0 ft.

From 0 ft. to 0 ft., From 0 ft. to 0 ft.

GRAVEL PACK INTERVALS: From 20 ft. to 265 ft., From 0 ft. to 0 ft.

From 0 ft. to 0 ft., From 0 ft. to 0 ft.

6 GROUT MATERIAL BENTONITE

Grout Intervals: From 0 ft. to 20 ft., From 0 ft. to 0 ft., From 0 ft. to 0 ft.

What is the nearest source of possible contamination: NONE - NEW SITE

Direction from well?

How many feet? 0

FROM	TO	LITHOLOGIC LOG	FROM	TO	PLUGGING INTERVALS
0	20	TOPSOIL FINE SAND			
20	40	FINE SAND			
40	80	FINE - MED SAND			
80	132	FINE - MED SAND SMALL GRAVEL			
132	136	CLAY			
136	80	CLAY FINE SAND IN LAYERS			
180	215	MED-COARSE SAND SMALL GRAVEL			
215	265	MED-COARSE SAND SMALL GRAVEL			
265	0	CLAY			

7 CONTRACTOR'S OR LANDOWNER'S CERTIFICATION: This water well was Constructed under my jurisdiction and was completed on (mo/day/year) 09/17/92 and this record is true to the best of my knowledge and belief. Kansas Water Well Contractor's License No. 179 This Water Well Record was completed on (mo/day/yr) 10/14/92 under the business name of JOE'S WELL SERVICE, INC.

by (signature) *Joe's Well Service, Inc.*