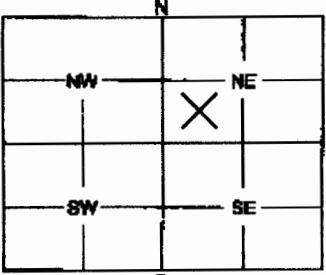
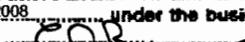


1	LOCATION OF WATER WELL:	Fraction	Section Number	Township Number	Range Number																								
County: Gray		NE $\frac{1}{4}$ SW $\frac{1}{4}$ NE $\frac{1}{4}$	27	26S	27W E/W																								
Distance and direction from nearest town or city street address of well if located within city? N/A																													
2	WATER WELL OWNER: Powerline Dairy, LLC dba Forget-me-not Farms RR #, St. Address, Box #: PO Box 1240, Cimarron, KS 67835 City, State, ZIP Code :					Board of Agriculture, Division of Water Resources Application Number: 25,265																							
3	MARK WELL'S LOCATION WITH AN "X" IN SECTION BOX:	4	DEPTH OF WELL 250 ft.																										
			WELL'S STATIC WATER LEVEL 82 ft.																										
WELL WAS USED AS:																													
<table border="0"> <tr> <td>1 Domestic</td> <td>5 Public Water Supply</td> <td>9 Dewatering</td> </tr> <tr> <td>2 Irrigation</td> <td>6 Oil Field Water Supply</td> <td>10 Monitoring Well</td> </tr> <tr> <td>3 Feedlot</td> <td>7 Domestic (Lawn & Garden)</td> <td>11 Injection Well</td> </tr> <tr> <td>4 Industrial</td> <td>8 Air Conditioning</td> <td>12 Other</td> </tr> </table>						1 Domestic	5 Public Water Supply	9 Dewatering	2 Irrigation	6 Oil Field Water Supply	10 Monitoring Well	3 Feedlot	7 Domestic (Lawn & Garden)	11 Injection Well	4 Industrial	8 Air Conditioning	12 Other												
1 Domestic	5 Public Water Supply	9 Dewatering																											
2 Irrigation	6 Oil Field Water Supply	10 Monitoring Well																											
3 Feedlot	7 Domestic (Lawn & Garden)	11 Injection Well																											
4 Industrial	8 Air Conditioning	12 Other																											
Was a chemical / bacteriological sample submitted to Department? Yes No <input checked="" type="checkbox"/>																													
If yes, mo/day/yr sample was submitted _____																													
Water Well Disinfected: Yes No <input checked="" type="checkbox"/>																													
5	TYPE OF BLANK CASING USED:																												
<table border="0"> <tr> <td>X 1 Steel</td> <td>3 RMP (SR)</td> <td>5 Wrought</td> <td>7 Fiberglass</td> <td>9 Other (Specify below)</td> </tr> <tr> <td>2 PVC</td> <td>4 ABS</td> <td>6 Asbestos-Cement</td> <td>8 Concrete Tile</td> <td></td> </tr> </table>						X 1 Steel	3 RMP (SR)	5 Wrought	7 Fiberglass	9 Other (Specify below)	2 PVC	4 ABS	6 Asbestos-Cement	8 Concrete Tile															
X 1 Steel	3 RMP (SR)	5 Wrought	7 Fiberglass	9 Other (Specify below)																									
2 PVC	4 ABS	6 Asbestos-Cement	8 Concrete Tile																										
Blank casing diameter 16 in.		Was casing pulled? Yes <input checked="" type="checkbox"/>		No If yes, how much 8 feet																									
Casing height above or below land surface in.																													
6	GROUT PLUG MATERIAL:																												
<table border="0"> <tr> <td>1 Need cement</td> <td>2 Cement grout</td> <td>3 Bentonite</td> <td>4 Other</td> </tr> <tr> <td>Grout Plug Intervals: From 8 feet ft.</td> <td>to 250 ft.</td> <td>From ft.</td> <td>to ft.</td> <td>From ft.</td> <td>to ft.</td> </tr> </table>						1 Need cement	2 Cement grout	3 Bentonite	4 Other	Grout Plug Intervals: From 8 feet ft.	to 250 ft.	From ft.	to ft.	From ft.	to ft.														
1 Need cement	2 Cement grout	3 Bentonite	4 Other																										
Grout Plug Intervals: From 8 feet ft.	to 250 ft.	From ft.	to ft.	From ft.	to ft.																								
What is the nearest source of possible contamination:																													
<table border="0"> <tr> <td>1 Septic tank</td> <td>6 Seepage pit</td> <td>11 Fuel storage</td> <td>16 Other (specify below)</td> </tr> <tr> <td>2 Sewer lines</td> <td>7 Pit privy</td> <td>12 Fertilizer storage</td> <td></td> </tr> <tr> <td>3 Watertight sewer lines</td> <td>8 Sewage lagoon</td> <td>13 Insecticide storage</td> <td></td> </tr> <tr> <td>4 Lateral lines</td> <td>✓ 9 Feedyard</td> <td>14 Abandoned water well</td> <td></td> </tr> <tr> <td>5 Cess pool</td> <td>10 Livestock pens</td> <td>15 Oil well/Gas well</td> <td></td> </tr> </table>						1 Septic tank	6 Seepage pit	11 Fuel storage	16 Other (specify below)	2 Sewer lines	7 Pit privy	12 Fertilizer storage		3 Watertight sewer lines	8 Sewage lagoon	13 Insecticide storage		4 Lateral lines	✓ 9 Feedyard	14 Abandoned water well		5 Cess pool	10 Livestock pens	15 Oil well/Gas well					
1 Septic tank	6 Seepage pit	11 Fuel storage	16 Other (specify below)																										
2 Sewer lines	7 Pit privy	12 Fertilizer storage																											
3 Watertight sewer lines	8 Sewage lagoon	13 Insecticide storage																											
4 Lateral lines	✓ 9 Feedyard	14 Abandoned water well																											
5 Cess pool	10 Livestock pens	15 Oil well/Gas well																											
Direction from well? N/A How many feet? <50 feet																													
<table border="1"> <thead> <tr> <th>FROM</th> <th>TO</th> <th>PLUGGING MATERIALS</th> </tr> </thead> <tbody> <tr> <td>0 feet</td> <td>8 feet</td> <td>Compacted Soil</td> </tr> <tr> <td>8 feet</td> <td>250 feet</td> <td>Cement Grout</td> </tr> <tr> <td></td> <td></td> <td></td> </tr> </tbody> </table>						FROM	TO	PLUGGING MATERIALS	0 feet	8 feet	Compacted Soil	8 feet	250 feet	Cement Grout															
FROM	TO	PLUGGING MATERIALS																											
0 feet	8 feet	Compacted Soil																											
8 feet	250 feet	Cement Grout																											
7	CONTRACTOR'S OF LANDOWNER'S CERTIFICATION: This water well was plugged under my jurisdiction and was completed on (mo/day/year) 04/28/2008 and this record is true to the best of my knowledge and belief. Kansas Water Well Contractor's License No. N/A This Water Well Record was completed on (mo/day/year) 10/31/2008 under the business name of Powerline Dairy, LLC dba Forget-me-not Farms.																												
by (signature) 																													
INSTRUCTIONS: Use typewriter or ball point pen. Please press firmly and print clearly. Please fill in blanks, underline or circle the correct answers. Send top three copies to Kansas Department of Health and Environment, Bureau of Water, Geology Section, 1000 SW Jackson St., Ste. 420, Topeka, Kansas 66612-1367. Telephone: 785/296-5522. Send one to Water Well Owner and retain one for your records.																													