

## WATER WELL PLUGGING RECORD Form WWC-5P

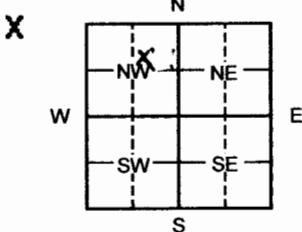
KSA 82a-1212

ID NO.

GY-07

<b>1 LOCATION OF WATER WELL:</b>		Fraction County: Gray	NE ¼	NW ¼	Section Number 13	Township Number 26	Range Number 27 E/W
Distance and direction from nearest town or city street address of well if located within city? From Cimarron, appx. 5 ¾ mi. East, ½ mi. South,							

<b>2 WATER WELL OWNER:</b> Dan Miller		Global Positioning System (decimal degrees, min. of 4 digits)					
RR#, St. Address, Box #: PO Box 314		Latitude: _____					
City, State, ZIP Code: Cimarron, Ks, 67835		Longitude: _____					
		Elevation: _____					
		Datum: _____					
		Data Collection Method: _____					

<b>3 MARK WELL'S LOCATION WITH AN "X" IN SECTION BOX:</b>	<b>4 DEPTH OF WELL</b> 153 ft.												
	<b>WELL'S STATIC WATER LEVEL</b> Apprx 62 ft												
	<b>WELL WAS USED AS:</b>												
	<table border="0"> <tr> <td>1 Domestic</td> <td>5 Public Water Supply</td> <td>9 Dewatering</td> </tr> <tr> <td>2 Irrigation</td> <td>6 Oil Field Water Supply</td> <td>10 Monitoring</td> </tr> <tr> <td>3 Feedlot</td> <td>7 Domestic (Lawn &amp; Garden)</td> <td>11 Injection Well</td> </tr> <tr> <td>4 Industrial</td> <td>8 Air Conditioning</td> <td>12 Other _____</td> </tr> </table>	1 Domestic	5 Public Water Supply	9 Dewatering	2 Irrigation	6 Oil Field Water Supply	10 Monitoring	3 Feedlot	7 Domestic (Lawn & Garden)	11 Injection Well	4 Industrial	8 Air Conditioning	12 Other _____
1 Domestic	5 Public Water Supply	9 Dewatering											
2 Irrigation	6 Oil Field Water Supply	10 Monitoring											
3 Feedlot	7 Domestic (Lawn & Garden)	11 Injection Well											
4 Industrial	8 Air Conditioning	12 Other _____											
	Was a chemical/bacteriological sample submitted to Department? Yes <input type="checkbox"/> No <input checked="" type="checkbox"/>												

<b>5 TYPE OF BLANK CASING USED:</b>										
<table border="0"> <tr> <td>1 Steel</td> <td>3 RMP (SR)</td> <td>5 Wrought</td> <td>7 Fiberglass</td> <td>9 Other (Specify below)</td> </tr> <tr> <td>2 PVC</td> <td>4 ABS</td> <td>6 Asbestos-Cement</td> <td>8 Concrete Tile</td> <td>_____</td> </tr> </table>	1 Steel	3 RMP (SR)	5 Wrought	7 Fiberglass	9 Other (Specify below)	2 PVC	4 ABS	6 Asbestos-Cement	8 Concrete Tile	_____
1 Steel	3 RMP (SR)	5 Wrought	7 Fiberglass	9 Other (Specify below)						
2 PVC	4 ABS	6 Asbestos-Cement	8 Concrete Tile	_____						
Blank casing diameter 16 in. Was casing pulled? Yes <input type="checkbox"/> No <input checked="" type="checkbox"/> If yes, how much _____										
Casing height above or below land surface -48 in.										

<b>6 GROUT PLUG MATERIAL:</b> 1 Neat cement	2 Cement grout	3 Bentonite	4 Other _____
Grout Plug Intervals: From 4 ft. to 18 ft., From	ft. to	ft., From	to ft.
What is the nearest source of possible contamination:	None observed		
1 Septic tank	6 Seepage pit	11 Fuel Storage	16 Other (specify below)
2 Sewer lines	7 Pit privy	12 Fertilizer storage	_____
3 Watertight sewer lines	8 Sewage lagoon	13 Insecticide storage	_____
4 Lateral lines	9 Feedyard	14 Abandoned water well	Direction from well?
5 Cess pool	10 Livestock pens	15 Oil well/Gas well	How many feet?

FROM	TO	PLUGGING MATERIALS	FROM	TO	PLUGGING MATERIALS
0	4	Backfill			
4	18	Concrete			
18	60	Clay			
60	153	Sand			

<b>7 CONTRACTOR'S OR LANDOWNER'S CERTIFICATION:</b> This water well was plugged under my jurisdiction and was completed on (mo/day/year) 9/15/08 and this record is true to the best of my knowledge and belief. Kansas Water Well Contractor's License No. 145. This Water Well Record was completed on (mo/day/year) 11/12/08 under the business name of Henkle Drilling & Supply Co., Inc. by (signature) <i>Benj. Reinhart</i>
--