

WATER WELL PLUGGING RECORD Form WWC-5P KSA 82a-1212 ID NO. _____

1 LOCATION OF WATER WELL: Fraction NE 1/4 1/4 1/4 SW 1/4 Section Number 31 Township Number 26T 27S Range Number E W

County: Gray
Street/Rural Address of Well Location; if unknown, distance & direction from nearest town or intersection: If at owner's address, check here

Global Positioning Systems (GPS) information:

Latitude: _____ (in decimal degrees)

Longitude: _____ (in decimal degrees)

Elevation: _____

Datum: WGS84, NAD83, NAD27

Collection Method:

GPS unit (Make/Model: _____)

Digital Map/Photo, Topographic Map, Land Survey


Est. Accuracy: < 3 m, 3-5 m, 5-15 m, > 15 m

2 WATER WELL OWNER: Circle D Farms LLC

RR#, St. Address, Box #: PO Box 195

City, State ZIP Code: Cimarron, KS 67835

3 MARK WELL'S LOCATION WITH AN "X" IN SECTION BOX:

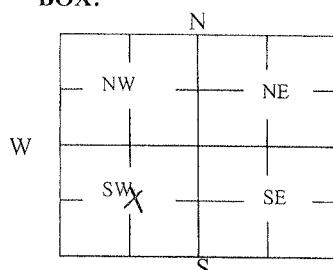

4 DEPTH OF WELL 200 ft.

WELL'S STATIC WATER LEVEL 165 ft

WELL WAS USED AS:

Domestic
 Irrigation
 Feedlot
 Industrial

Public Water Supply
 Oil Field Water Supply
 Domestic (Lawn & Garden)
 Air Conditioning

Dewatering
 Monitoring
 Injection Well
 Other _____

Was a chemical/bacteriological sample submitted to Department? Yes No

5 TYPE OF BLANK CASING USED:

Steel
 PVC

RMP (SR)
 ABS

Wrought
 Asbestos-Cement

Fiberglass
 Concrete Tile

Other (Specify below) _____

Blank casing diameter 16 in. Was casing pulled? Yes No If yes, how much _____
Casing height above or below land surface 60 in.

6 GROUT PLUG MATERIAL: Neat cement Cement grout Bentonite Other Quikrete

Grout Plug Intervals: From 165 ft. to 164 ft., From 9 ft. to 5 ft., From _____ to _____ ft.

What is the nearest source of possible contamination:

Septic tank
 Sewer lines
 Watertight sewer lines
 Lateral lines
 Cess pool

Seepage pit
 Pit privy
 Sewage lagoon
 Feedyard
 Livestock pens

Fuel Storage
 Fertilizer storage
 Insecticide storage
 Abandoned water well
 Oil well/Gas well

Other (specify below) _____

Direction from well? E
How many feet? 2500

FROM	TO	PLUGGING MATERIALS	FROM	TO	PLUGGING MATERIALS
			<u>200</u>	<u>165</u>	<u>Gravel</u>
			<u>165</u>	<u>164</u>	<u>Bentonite</u>
			<u>164</u>	<u>9</u>	<u>Sand & Clay</u>
			<u>9</u>	<u>8</u>	<u>Bentonite</u>
			<u>8</u>	<u>4 1/2</u>	<u>Quikrete</u>

7 CONTRACTOR'S OR LANDOWNER'S CERTIFICATION: This water well was plugged under my jurisdiction and was completed on (mo/day/year) 3-15-13 and this record is true to the best of my knowledge and belief. Kansas Water Well Contractor's License No. 31577. This Water Well Record was completed on (mo/day/year) 3-15-13 under the business name of Circle D Farms by (signature) Elder R. Dickey

INSTRUCTIONS: Use typewriter or ballpoint pen. Please press firmly and print clearly. Please fill in blanks, underline or circle the correct answers. Send top three copies to Kansas Department of Health and Environment, Bureau of Water, Geology Section, 1000 SW Jackson St., Ste. 420, Topeka, Kansas 66612-1367. Telephone: 785/296-5524. Send one to Water Well Owner and retain one for your records. Visit us at <http://www.kdheks.gov/waterwell/index.html>.