

## WATER WELL PLUGGING RECORD

Form WWC-5P

KSA 82a-1212

ID NO. \_\_\_\_\_

1 LOCATION OF WATER WELL:		Fraction <u>NC</u> <u>1/4</u> <u>1/4</u> <u>1/4</u> <u>SW 1/4</u>	Section Number <u>32</u>	Township Number <u>26T</u> <u>27S</u>	Range Number <u>E</u> <input checked="" type="checkbox"/> <u>W</u>
---------------------------	--	--	--------------------------	---------------------------------------	--

Street/Rural Address of Well Location; If unknown, distance & direction from nearest town or intersection: If at owner's address, check here

## Global Positioning Systems (GPS) information:

Latitude: \_\_\_\_\_ (in decimal degrees)

Longitude: \_\_\_\_\_ (in decimal degrees)

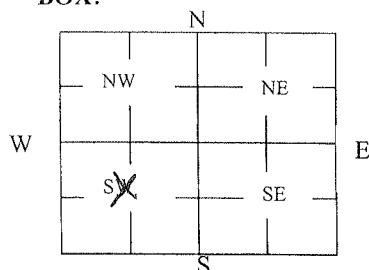
Elevation:

Datum:  WGS84,  NAD83,  NAD27

## Collection Method:

 GPS unit (Make/Model): \_\_\_\_\_ Digital Map/Photo,  Topographic Map,  Land SurveyEst. Accuracy:  < 3 m,  3-5 m,  5-15 m,  > 15 m2 WATER WELL OWNER: Circle D Farms LLCRR#, St. Address, Box #: PO Box 195City, State ZIP Code: Cimarron, KS 67835

## 3 MARK WELL'S LOCATION WITH AN "X" IN SECTION BOX:

4 DEPTH OF WELL 200 ft.WELL'S STATIC WATER LEVEL 142 ft

WELL WAS USED AS:

Domestic  
 Irrigation  
 Feedlot  
 Industrial

Public Water Supply  
 Oil Field Water Supply  
 Domestic (Lawn & Garden)  
 Air Conditioning

Dewatering  
 Monitoring  
 Injection Well  
 Other \_\_\_\_\_

Was a chemical/bacteriological sample submitted to Department? Yes  No 

## 5 TYPE OF BLANK CASING USED:

Steel  
 PVC

RMP (SR)  
 ABS

Wrought  
 Asbestos-Cement

Fiberglass  
 Concrete Tile

Other (Specify below)

Blank casing diameter 16 in. Was casing pulled? Yes  No  If yes, how much \_\_\_\_\_  
Casing height above or below land surface 60 in.

6 GROUT PLUG MATERIAL:  Neat cement  Cement grout  Bentonite  Other QuikreteGrout Plug Intervals: From 142 ft. to 141 ft., From 9 ft. to 5 ft., From \_\_\_\_\_ to \_\_\_\_\_ ft.

What is the nearest source of possible contamination:

Septic tank  
 Sewer lines  
 Watertight sewer lines  
 Lateral lines  
 Cess pool

Seepage pit  
 Pit-privy  
 Sewage lagoon  
 Feedyard  
 Livestock pens

Fuel Storage  
 Fertilizer storage  
 Insecticide storage  
 Abandoned water well  
 Oil well/Gas well

Other (specify below)

Direction from well? WHow many feet? 2520

FROM	TO	PLUGGING MATERIALS	FROM	TO	PLUGGING MATERIALS
			<u>200</u>	<u>142</u>	<u>Gravel /</u>
			<u>142</u>	<u>141</u>	<u>Bentonite</u>
			<u>141</u>	<u>9</u>	<u>Sand &amp; Clay</u>
			<u>9</u>	<u>8</u>	<u>Bentonite</u>
			<u>8</u>	<u>4 1/2</u>	<u>Quikrete</u>

7 CONTRACTOR'S OR LANDOWNER'S CERTIFICATION: This water well was plugged under my jurisdiction and was completed on (mo/day/year) 3-15-13 and this record is true to the best of my knowledge and belief. Kansas Water Well Contractor's License No. 312121367. This Water Well Record was completed on (mo/day/year) 3-15-13 under the business name of Circle D Farms by (signature) Elmer R. Duchs

INSTRUCTIONS: Use typewriter or ballpoint pen. Please press firmly and print clearly. Please fill in blanks, underline or circle the correct answers. Send top three copies to Kansas Department of Health and Environment, Bureau of Water, Geology Section, 1000 SW Jackson St., Ste. 420, Topeka, Kansas 66612-1367. Telephone: 785/296-5524. Send one to Water Well Owner and retain one for your records. Visit us at <http://www.kdheks.gov/waterwell/index.html>.