

WATER WELL RECORD Form WWC-5

Division of Water Resources App. No.


14591

Well ID

Original Record Correction Change in Well Use

1 LOCATION OF WATER WELL: County: Gray Fraction SE ¼ SW ¼ SE ¼ NE ¼ Section Number 18 Township Number T 26 S Range Number R 27 E W

2 WELL OWNER: Last Name: Business: Forget Me Not Farms First: Address: 22502 R Road City: Cimarron State: KS ZIP: 67835 Street or Rural Address where well is located (if unknown, distance and direction from nearest town or intersection): If at owner's address, check here:

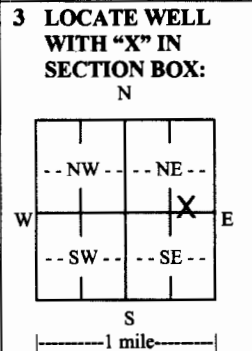

4 DEPTH OF COMPLETED WELL: 220 ft. Depth(s) Groundwater Encountered: 1) 89 ft. 2) 89 ft. 3) 89 ft. or 4) Dry Well WELL'S STATIC WATER LEVEL: 89 ft. below land surface, measured on (mo-day-yr) 02/20/2016 above land surface, measured on (mo-day-yr) Pump test data: Well water was _____ ft. after _____ hours pumping _____ gpm Well water was _____ ft. after _____ hours pumping _____ gpm Estimated Yield: 800 gpm Bore Hole Diameter: 26 in. to 220 ft. and _____ in. to _____ ft.

5 Latitude: 37.78845 (decimal degrees) **Longitude:** 100.309232 (decimal degrees) **Datum:** WGS 84 NAD 83 NAD 27 **Source for Latitude/Longitude:** GPS (unit make/model: _____) (WAAS enabled? Yes No) Land Survey Topographic Map Online Mapper: _____ **6 Elevation:** 2598 ft. Ground Level TOC **Source:** Land Survey GPS Topographic Map Other KOLAR

7 WELL WATER TO BE USED AS:

1. Domestic: Household Lawn & Garden Livestock Irrigation Feedlot Industrial

2. Public Water Supply: well ID _____

3. Dewatering: how many wells? _____

4. Aquifer Recharge: well ID _____

5. Monitoring: well ID _____

6. Environmental Remediation: well ID _____

7. Air Sparge Soil Vapor Extraction Recovery Injection

8. Oil Field Water Supply: lease _____

9. Test Hole: well ID _____

10. Cased Uncased Geotechnical

11. Geothermal: how many bores? _____

12. a) Closed Loop Horizontal Vertical

13. b) Open Loop Surface Discharge Inj. of Water

14. Other (specify): _____

Was a chemical/bacteriological sample submitted to KDHE? Yes No If yes, date sample was submitted: _____

Water well disinfected? Yes No

8 TYPE OF CASING USED: Steel PVC Other CASING JOINTS: Glued Clamped Welded Threaded

Casing diameter 16 in. to 220 ft., Diameter _____ in. to _____ ft., Diameter _____ in. to _____ ft.

Casing height above land surface 12 in. Weight _____ lbs./ft. Wall thickness or gauge No. SCH40

TYPE OF SCREEN OR PERFORATION MATERIAL: Steel Stainless Steel Fiberglass PVC Other (Specify) _____

Brass Galvanized Steel Concrete tile None used (open hole)

SCREEN OR PERFORATION OPENINGS ARE: Continuous Slot Mill Slot Gauze Wrapped Torch Cut Drilled Holes Other (Specify) _____

Louvered Shutter Key Punched Wire Wrapped Saw Cut None (Open Hole)

SCREEN-PERFORATED INTERVALS: From 120 ft. to 220 ft., From _____ ft. to _____ ft., From _____ ft. to _____ ft.

GRAVEL PACK INTERVALS: From 25 ft. to 220 ft., From _____ ft. to _____ ft., From _____ ft. to _____ ft.

9 GROUT MATERIAL: Neat cement Cement grout Bentonite Other

Grout intervals: From 0 ft. to 25 ft., From _____ ft. to _____ ft., From _____ ft. to _____ ft.

Nearest source of possible contamination:

Septic Tank Lateral Lines Pit Privy Livestock Pens Insecticide Storage

Sewer Lines Cess Pool Sewage Lagoon Fuel Storage Abandoned Water Well

Watertight Sewer Lines Seepage Pit Feedyard Fertilizer Storage Oil Well/Gas Well

Other (Specify) _____

Direction from well? SW Distance from well? 50 ft.

10 FROM	TO	LITHOLOGIC LOG	FROM	TO	LITHO. LOG (cont.) or PLUGGING INTERVALS
0	40	Fine coarse sand med gravel			
40	60	Fine coarse sand w/tan streaks			
60	80	Tan clay w/fine med layers			
80	140	Fine med sand. Tan clay streaks			
140	160	Fine coarse sand w/small gravel streaks			
160	180	Fine coarse sand w/small gravel layers			
180	200	Fine coarse sand w/small to large gravel			
200	211	Fine tight w/coarse streaks			Notes:
211	220	Blue Shale			

11 CONTRACTOR'S OR LANDOWNER'S CERTIFICATION: This water well was constructed, reconstructed, or plugged under my jurisdiction and was completed on (mo-day-year) _____ and this record is true to the best of my knowledge and belief. Kansas Water Well Contractor's License No. 846 This Water Well Record was completed on (mo-day-year) 05/06/2016 under the business name of Nash Water Well Service, LLC