

WATER WELL RECORD Form WWC-5 KSA 82a-1212

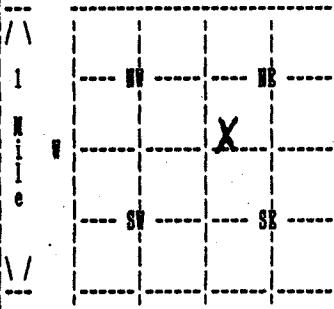
1 LOCATION OF WATER WELL:	Fraction COUNTY: GRAY	1/4 SW. 1/4 NW. 1/4 NE. 1/4 SE.	Section Number 8	Township Number 126	Range Number 8 27
---------------------------	--------------------------	---------------------------------	---------------------	------------------------	----------------------

Distance and direction from nearest town or city street address of well if located within city?
FROM CINARON - 1 1/2 MILES EAST ON HIGHWAY 50

2 WATER WELL OWNER: SALMANS, ELLA MAE MRS. RE, St. Address, Box #:	Board of Agriculture, Division of Water Resources
---	---

City, State, ZIP code : CINARON, KS 67835-	Application Number:
--	---------------------

3 LOCATE WELL'S LOCATION WITH AN 'X' IN SECTION BOX:	4 DEPTH OF COMPLETED WELL 0 ELEVATION: 0 Depth(s) Groundwater Encountered 1. 0 ft. 2. 0 ft. 3. 0 ft.
---	---

	WELL'S STATIC WATER LEVEL 0 ft. below land surface measured on no/day/yr Pump testdata: Well water was 0 ft. after 0 hours pumping 0 gpm Estimated Yield 0 gpm: Well water was 0 ft. after 0 hours pumping 0 gpm Bore Hole Diameter in. to 0 ft., and in. to 0 ft. WELL WATER WAS: DOMESTIC Was a chemical/bacteriological sample submitted to department? No ; If yes, no/day/yr sample was submitted Water well disinfected? Yes
--	--

5 TYPE OF BLANK CASING USED:	CASING JOINTS: Blank casing diameter 4 in. to 67 ft., Dia in. to 0 ft., Dia in. to 0 ft. Casing height above land surface 0 in., weight 0 lbs/ft. Wall thickness or gauge No.
------------------------------	---

TYPE OF SCREEN OR PERFORATION MATERIAL:
SCREEN OR PERFORATION OPENINGS ARE:

SCREEN PERFORATED INTERVALS:	From 0 ft. to 0 ft., From 0 ft. to 0 ft.
GRAVEL PACK INTERVALS:	From 0 ft. to 0 ft., From 0 ft. to 0 ft.

6 GROUT MATERIAL BENTONITE Grout Intervals: From 0 ft. to 40 ft., From 0 ft. to 0 ft., From 0 ft. to 0 ft.	What is the nearest source of possible contamination: NONE	Direction from well? How many feet? 0
---	--	---------------------------------------

FROM	TO	LITHOLOGIC LOG	FROM	TO	PLUGGING INTERVALS
			0	2	CEMENT
			2	10	BENTONITE GROUT
			10	67	FILL SAND
			0	0	
			0	0	
			0	0	
			0	0	
			0	0	

7 CONTRACTOR'S OR LANDOWNER'S CERTIFICATION: This water well was Plugged under my jurisdiction and was completed on (no/day/year) 07/18/94 and this record is true to the best of my knowledge and belief. Kansas Water Well Contractor's License No. 179 This Water Well Record was completed on (no/day/yr) 09/06/94 under the business name of JOB'S WELL SERVICE, INC.	by (signature) <i>Quinton Clark</i>
--	-------------------------------------