WATER WELL RECORD Form WWC-5 KSA 82a-1212

1 LOCATION OF WATER WELL: County: Gray | Fraction: Near Center ¼ ¼ NW ¼ | Section Number: 24 | Township Number: T 26 S | Range Number: R 28 E W

Distance and direction from nearest town or city street address of well if located within city?
From south side of Cimarron - 2½ Miles South, 1 Mile East, 3,770 Ft. North & 4,050 Ft. West

2 WATER WELL OWNER: Carl Leatherwood
RR#, St. Address, Box # : P. O. Box 788
City, State, ZIP Code : Cimarron, Kansas 67835
Board of Agriculture, Division of Water Resources
Application Number: 21,534

3 LOCATE WELL'S LOCATION WITH AN "X" IN SECTION BOX:

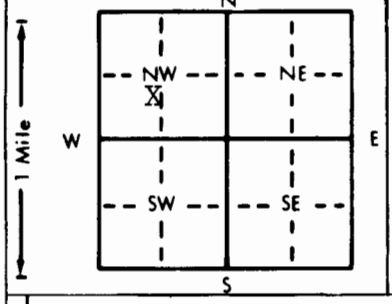

4 DEPTH OF COMPLETED WELL 265 ft. ELEVATION:
Depth(s) Groundwater Encountered 1. ft. 2. ft. 3. ft.
WELL'S STATIC WATER LEVEL 113 ft. below land surface measured on mo/day/yr 6-29-95
Pump test data: Well water was ft. after hours pumping gpm
Est. Yield gpm: Well water was ft. after hours pumping gpm
Bore Hole Diameter 30 in. to 265 ft., and in. to ft.
WELL WATER TO BE USED AS: 1 Domestic 2 Irrigation 3 Feedlot 4 Industrial 5 Public water supply 6 Oil field water supply 7 Lawn and garden only 8 Air conditioning 9 Dewatering 10 Monitoring well 11 Injection well 12 Other (Specify below)
Was a chemical/bacteriological sample submitted to Department? Yes No X; If yes, mo/day/yr sample was submitted
Water Well Disinfected? Yes No X

5 TYPE OF BLANK CASING USED: 1 Steel 2 PVC 3 RMP (SR) 4 ABS 5 Wrought iron 6 Asbestos-Cement 7 Fiberglass 8 Concrete tile 9 Other (specify below)
CASING JOINTS: Glued Clamped Welded X Threaded
Blank casing diameter 16 in. to 140 ft., Dia in. to ft., Dia in. to ft.
Casing height above land surface 12 in., weight 42.05 lbs./ft. Wall thickness or gauge No. .250

TYPE OF SCREEN OR PERFORATION MATERIAL: 1 Steel 2 Brass 3 Stainless steel 4 Galvanized steel 5 Fiberglass 6 Concrete tile 7 PVC 8 RMP (SR) 9 ABS 10 Asbestos-cement 11 Other (specify) 12 None used (open hole)
SCREEN OR PERFORATION OPENINGS ARE: 1 Continuous slot 2 Louvered shutter 3 Mill slot 4 Key punched 5 Gauzed wrapped 6 Wire wrapped 7 Torch cut 8 Saw cut 9 Drilled holes 10 Other (specify) 11 None (open hole)
SCREEN-PERFORATED INTERVALS: From 140 ft. to 265 ft., From ft. to ft.
From ft. to ft., From ft. to ft.
GRAVEL PACK INTERVALS: From 30 ft. to 265 ft., From ft. to ft.
From ft. to ft., From ft. to ft.

6 GROUT MATERIAL: 1 Neat cement 2 Cement grout 3 Bentonite 4 Other
Grout Intervals: From 0 ft. to 30 ft., From ft. to ft., From ft. to ft.
What is the nearest source of possible contamination: 1 Septic tank 2 Sewer lines 3 Watertight sewer lines 4 Lateral lines 5 Cess pool 6 Seepage pit 7 Pit privy 8 Sewage lagoon 9 Feedyard 10 Livestock pens 11 Fuel storage 12 Fertilizer storage 13 Insecticide storage 14 Abandoned water well 15 Oil well/Gas well 16 Other (specify below)
Direction from well? North How many feet? 190

FROM	TO	LITHOLOGIC LOG	FROM	TO	PLUGGING INTERVALS
		See attached log			

7 CONTRACTOR'S OR LANDOWNER'S CERTIFICATION: This water well was (1) constructed, (2) reconstructed, or (3) plugged under my jurisdiction and was completed on (mo/day/year) 7-3-95 and this record is true to the best of my knowledge and belief. Kansas Water Well Contractor's License No. 208 This Water Well Record was completed on (mo/day/yr) 7-10-95
under the business name of Minter-Wilson Drilling Co., Inc. by (signature) Nora Keller

INSTRUCTIONS: Use typewriter or ball point pen. *PLEASE PRESS FIRMLY* and *PRINT* clearly. Please fill in blanks, underline or circle the correct answers. Send top three copies to Kansas Department of Health and Environment, Bureau of Water, Topeka, Kansas 66620-0001. Telephone: 913-296-5545. Send one to WATER WELL OWNER and retain one for your records.

OFFICE USE ONLY T R E/W SEC. ¼ ¼ ¼

The Professionals

MINTER-WILSON DRILLING CO.
INCORPORATED

Irrigation and Domestic Water Systems
Complete Installation and Repairing

Phone 276-8269 • P.O. Box A • GARDEN CITY, KANSAS 67846

Carl Leatherwood
Gray County
6/9/95

Location: NW¼ 24-26-28
From Cimarron Bridge - 1½ Miles South,
1/8th East & ¼ Mile Southeast to pivot
(Old well 87 Ft. west of pivot)
(Offset 200 Ft. South of old well)

Static Water Level - about 60'

Test #1

0'	to	1'	Top soil
1'	to	27'	Fine sand - loose
27'	to	36'	Brown clay
36'	to	42'	Fine to medium sand and gravel-loose
42'	to	60'	Medium coarse gravel - loose
60'	to	82'	Coarse gravel - loose
82'	to	95'	Brown sandy clay
95'	to	104'	Fine to medium sand and gravel-loose
104'	to	113'	Brown sandy clay
113'	to	117'	Fine to medium sand and gravel-loose
117'	to	124'	Brown sandy clay
124'	to	134'	Fine to medium sand and gravel-loose
134'	to	142'	Brown clay
142'	to	182'	Fine to medium sand-10% clay - loose
182'	to	195'	Brown sandy clay
195'	to	200'	Fine to medium sand and gravel - small yellow rock mixed - loose
200'	to	257'	Medium coarse gravel - yellow rock mixed - loose
257'	to	275'	Shale - hard pull down