

WATER WELL RECORD Form WWC-5 KSA 82a-1212

1 LOCATION OF WATER WELL:	Fraction County: Gray SE $\frac{1}{4}$ NE $\frac{1}{4}$	Section Number 11	Township Number T 26 S	Range Number R 28 E
---------------------------	--	----------------------	---------------------------	------------------------


Distance and direction from nearest town or city street address of well if located within city?

202 N. Main Cimarron, KS.

2 WATER WELL OWNER: Grain Growers Coop
RR#, St. Address, Box #: 202 N. Main
City, State, ZIP Code Cimarron, KS.

Board of Agriculture, Division of Water Resources
Application Number:

3 LOCATE WELL'S LOCATION WITHIN SECTION BOX:
AN "X" IN SECTION BOX:

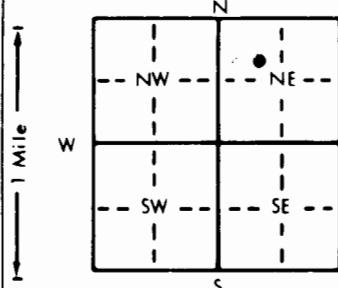

4 DEPTH OF COMPLETED WELL. **55'** ft. ELEVATION:

Depth(s) Groundwater Encountered **43 1/2'** ft. 2. ft. 3. ft.

WELL'S STATIC WATER LEVEL **44.0** ft. below land surface measured on mo/day/yr **11-3-97**

Pump test data: Well water was ft. after hours pumping gpm

Est. Yield gpm Well water was ft. after hours pumping gpm

Bore Hole Diameter **8 1/2"** in. to **55'** ft. and in. to ft.

WELL WATER TO BE USED AS: 5 Public water supply 8 Air conditioning 11 Injection well

1 Domestic 3 Feedlot 6 Oil field water supply 9 Dewatering 12 Other (Specify below)

2 Irrigation 4 Industrial 7 Lawn and garden only 10 Monitoring well

Was a chemical/bacteriological sample submitted to Department? Yes No If yes, mo/day/yr sample was submitted

Water Well Disinfected? Yes

No

5 TYPE OF BLANK CASING USED:

1 Steel 3 RMP (SR)
2 PVC 4 ABS

5 Wrought iron 8 Concrete tile CASING JOINTS: Glued Clamped

6 Asbestos-Cement 9 Other (specify below) Welded

7 Fiberglass Threaded

X

Blank casing diameter **2.375** in. to **35'** ft., Dia in. to ft., Dia in. to SDR 13 ft.

Casing height above land surface **FLUSH MT.** in., weight lbs./ft. Wall thickness or gauge No. SCh 40

TYPE OF SCREEN OR PERFORATION MATERIAL:

1 Steel 3 Stainless steel 5 Fiberglass 8 RMP (SR) 10 Asbestos-cement

2 Brass 4 Galvanized steel 6 Concrete tile 9 ABS 11 Other (specify)

12 None used (open hole) 11 None (open hole)

SCREEN OR PERFORATION OPENINGS ARE:

1 Continuous slot **3 Mill slot** 5 Gauzed wrapped 8 Saw cut 11 None (open hole)

2 Louvered shutter 4 Key punched 6 Wire wrapped 9 Drilled holes

3 SCREEN-PERFORATED INTERVALS: From **55'** ft. to **35'** ft. From ft. to ft.

From ft. to ft. From ft. to ft.

4 GRAVEL PACK INTERVALS: From **55'** ft. to **33'** ft. From ft. to ft.

From ft. to ft. From ft. to ft.

5 GROUT MATERIAL: 1 Neat cement **33'** ft. to **4'** **2** Cement grout **4'** **3** Bentonite **0'** 4 Other

Grout Intervals: From **33'** ft. to **4'** ft. From **4'** ft. to **0'** ft. From ft. to ft.

What is the nearest source of possible contamination:

1 Septic tank 4 Lateral lines 7 Pit privy 10 Livestock pens 14 Abandoned water well

2 Sewer lines 5 Cess pool 8 Sewage lagoon 11 Fuel storage **Former** 15 Oil well/Gas well

3 Watertight sewer lines 6 Seepage pit 9 Feedyard 12 Fertilizer storage 16 Other (specify below)

13 Insecticide storage

How many feet? **45'**

6 DIRECTION FROM WELL? **East**

FROM	TO	LITHOLOGIC LOG	FROM	TO	PLUGGING INTERVALS
0	.75	Concrete			
.75	5	Fine-med sandy clay fill, dry, soft, no odor.			
5	12	Lt brn silty clay, trace of caliche, dry, no odor, firm.			
12	16	Dk gray banding, mod odor, firm, low plasticity, trace of caliche.			
16	26'5	Lt brn silty clay w/ trace of caliche, moist-dry, firm.			
26'5	45	Dk brn silty clay to clay, dry, firm, trace of caliche. Lt brn silty clay w/ fine-coarse sand lens at 39', dry, no odor.			
45	55	Blk to gray fine-coarse sand, wet, well graded, strong odor.			

7 CONTRACTOR'S OR LANDOWNER'S CERTIFICATION: This water well was (1) **constructed** (2) reconstructed, or (3) plugged under my jurisdiction and was completed on (mo/day/year) **11-3-97** and this record is true to the best of my knowledge and belief. Kansas

Water Well Contractor's License No. **539** This Water Well Record was completed on (mo/day/yr) **11-7-97** by (signature) **James Biebel**