

## WATER WELL RECORD Form WWC-5 KSA 82a-1212

1 LOCATION OF WATER WELL:	Fraction County: Gray	SE $\frac{1}{4}$ NW $\frac{1}{4}$ NE $\frac{1}{4}$	Section Number 11	Township Number T 26 S	Range Number R 28 E
---------------------------	--------------------------	--	----------------------	---------------------------	------------------------

Distance and direction from nearest town or city street address of well if located within city?

202 N. Main Cimarron, KS.


2 WATER WELL OWNER: Grain Growers Coop

RR#, St. Address, Box #: 202 N. Main

City, State, ZIP Code: Cimarron, KS.

Board of Agriculture, Division of Water Resources  
Application Number:

3 LOCATE WELL'S LOCATION WITH AN "X" IN SECTION BOX:

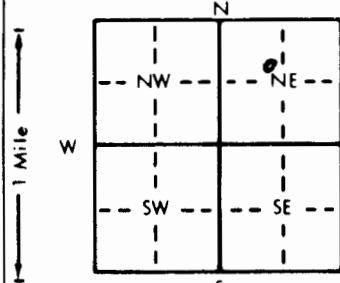

4 DEPTH OF COMPLETED WELL: 55' ft. ELEVATION: .....

Depth(s) Groundwater Encountered 1. 43' ft. 2. ft. 3. ft.

WELL'S STATIC WATER LEVEL 43' ft. below land surface measured on mo/day/yr 11-3-97

Pump test data: Well water was ft. after hours pumping gpm

Est. Yield gpm: Well water was ft. after hours pumping gpm

Bore Hole Diameter 8 1/2 in. to 55' ft. and in. to ft.

WELL WATER TO BE USED AS: 5 Public water supply 8 Air conditioning 11 Injection well

1 Domestic 3 Feedlot 6 Oil field water supply 9 Dewatering 12 Other (Specify below)

2 Irrigation 4 Industrial 7 Lawn and garden only 10 Monitoring well

Was a chemical/bacteriological sample submitted to Department? Yes No. If yes, mo/day/yr sample was submitted

Water Well Disinfected? Yes No

5 TYPE OF BLANK CASING USED:

1 Steel 3 RMP (SR)  
2 PVC 4 ABS

Blank casing diameter 2.375 in. to 35' ft. Dia. in. to ft. Dia. in. to ft. SDR 13 ft. SCh 40 lbs./ft. Wall thickness or gauge No.

TYPE OF SCREEN OR PERFORATION MATERIAL:

1 Steel 3 Stainless steel  
2 Brass 4 Galvanized steel

5 Wrought iron 8 Concrete tile  
6 Asbestos-Cement 9 Other (specify below)

7 Fiberglass

CASING JOINTS: Glued Clamped

Welded

Threaded X

SDR 13 ft.

SCh 40

10 Asbestos-cement

11 Other (specify)

12 None used (open hole)

SCREEN OR PERFORATION OPENINGS ARE:

1 Continuous slot 3 Mill slot  
2 Louvered shutter 4 Key punched

5 Gauzed wrapped 8 Saw cut 11 None (open hole)

6 Wire wrapped 9 Drilled holes

10 Other (specify)

SCREEN-PERFORATED INTERVALS: From 55' ft. to 35' ft. From ft. to ft. From ft. to ft.

GRAVEL PACK INTERVALS: From 55' ft. to 33' ft. From ft. to ft. From ft. to ft.

From ft. to ft. From ft. to ft.

6 GROUT MATERIAL: 1 Neat cement 2 Cement grout 3 Bentonite 4 Other

Grout Intervals: From 33' to 4' ft. From 4' ft. to 0' ft. From ft. to ft.

What is the nearest source of possible contamination:

1 Septic tank 4 Lateral lines 7 Pit privy 10 Livestock pens 14 Abandoned water well  
2 Sewer lines 5 Cess pool 8 Sewage lagoon 11 Fuel storage FORMER 15 Oil well/Gas well  
3 Watertight sewer lines 6 Seepage pit 9 Feedyard 12 Fertilizer storage 16 Other (specify below)

13 Insecticide storage

How many feet? 20'

Direction from well? East North East

FROM TO LITHOLOGIC LOG FROM TO PLUGGING INTERVALS

0	.75	Concrete			
.75	1.50	Brn silty clay, firm, moist.			
1.50	10	Med gray-blk silty clay w/ trace of sand, strong odor, soft.			
10	14'5	Lt brn gray clay to silty clay, trace of caliche, moist, mod to strong odor, firm.			
14'5	43	Lt brn silty clay w/ sand lens & caliche stringers, damp, mod. to strong odor.			
43	48'5	Lt gray brn sandy silty clay, moist-wet, firm, fine-med sand.			
48'5	55	Blk fine-med sand, wet, strong odor, well graded.			

7 CONTRACTOR'S OR LANDOWNER'S CERTIFICATION: This water well was (1) constructed (2) reconstructed, or (3) plugged under my jurisdiction and was completed on (mo/day/year) 539 and this record is true to the best of my knowledge and belief. Kansas

Water Well Contractor's License No. 539 This Water Well Record was completed on (mo/day/yr) by (signature) James Biebel