


1 LOCATION OF WATER WELL: Fraction Section Number Township Number Range Number  
 COUNTY: GRAY SW 1/4 SW 1/4 NE 1/4 6 T 26 S R 28 W

Distance and direction from nearest town or city street address of well if located within city?  
 4 MILES WEST ON HIGHWAY 50 - FROM CIMARRON, KS.

2 WATER WELL OWNER: O'NEAL, JOHN Board of Agriculture, Division of Water Resources  
 RR#, St. Address, Box #: BOX 665 Application Number:  
 City, State, ZIP code: CIMARRON, KS 67835-

3 LOCATE WELL'S LOCATION WITH AN "X" IN SECTION BOX:

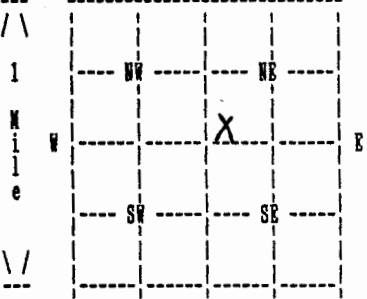

4 DEPTH OF COMPLETED WELL 30 ELEVATION: 0  
 Depth(s) Groundwater Encountered 1. 0 ft. 2. 0 ft. 3. 0 ft.  
 WELL'S STATIC WATER LEVEL 999 0 ft. below land surface measured on no/day/yr  
 Pump test data: Well water was 0 ft. after 0 hours pumping 0 gpm  
 Estimated Yield 0 gpm: Well water was 0 ft. after 0 hours pumping 0 gpm  
 Bore Hole Diameter 3 in. to 30 ft., and in. to 0 ft.  
 WELL WATER WAS: DOMESTIC  
 Was a chemical/bacteriological sample submitted to department? No;  
 If yes, no/day/yr sample was submitted Water well disinfected? Yes

5 TYPE OF BLANK CASING USED: STEEL CASING JOINTS: WELDED  
 Blank casing diameter 3 in. to 30 ft., Dia in. to 0 ft., Dia in. to 0 ft.  
 Casing height above land surface 24 in., weight 0 lbs/ft. Wall thickness or gauge No.  
 TYPE OF SCREEN OR PERFORATION MATERIAL: NA  
 SCREEN OR PERFORATION OPENINGS ARE: NA

SCREEN PERFORATED INTERVALS: From NA 0 ft. to NA 0 ft., From 0 ft. to 0 ft.  
 From 0 ft. to 0 ft., From 0 ft. to 0 ft.  
 GRAVEL PACK INTERVALS: From 0 ft. to 0 ft., From 0 ft. to 0 ft.  
 From 0 ft. to 0 ft., From 0 ft. to 0 ft.

6 GROUT MATERIAL Bentonite  
 Grout intervals: From 10 ft. to 2 ft., From 0 ft. to 0 ft., From 0 ft. to 0 ft.  
 What is the nearest source of possible contamination: NONE  
 Direction from well? How many feet? 0

FROM	TO	LITHOLOGIC LOG	FROM	TO	PLUGGING INTERVALS
			0	2	BLACK DIRT
			2	10	BENSEAL
			10	30	FILL SAND
			0	0	
			0	0	
			0	0	
			0	0	
			0	0	
			0	0	
			0	0	

7 CONTRACTOR'S OR LANDOWNER'S CERTIFICATION: This water well was plugged under my jurisdiction and was completed on (no/day/year) 04/29/93 and this record is true to the best of my knowledge and belief. Kansas Water Well Contractor's License No. 179 This Water Well Record was completed on (no/day/yr) 05/13/93 under the business name of JOE'S WELL SERVICE, INC. by (signature) *Joseph Cook*