

WATER WELL RECORD Form WWC-5 KSA 82a-1212

1 LOCATION OF WATER WELL:

Fraction

NE 1/4 SE 1/4 NE 1/4

Section Number

10

Township Number

T 26 S

Range Number

R 28 E

County: Gray

Distance and direction from nearest town or city street address of well if located within city?

From Junction 23 & 50, 1 1/4 mile West across railroad tracks

2 WATER WELL OWNER: Clarence Lee


RR#, St. Address, Box #: Box 621

City, State, ZIP Code: Cimarron, KS 67835

Board of Agriculture, Division of Water Resources

Application Number: 39364

3 LOCATE WELL'S LOCATION WITH AN "X" IN SECTION BOX:

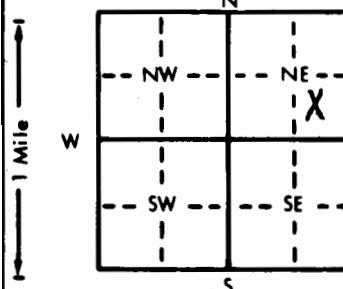

4 DEPTH OF COMPLETED WELL: 41 ft. ELEVATION:

Depth(s) Groundwater Encountered 1. ft. 2. ft. 3. ft.

WELL'S STATIC WATER LEVEL: 26 ft. below land surface measured on mo/day/yr 7-14-89

Pump test data: Well water was ft. after hours pumping gpm

Est. Yield gpm: Well water was ft. after hours pumping gpm

Bore Hole Diameter in. to ft. and in. to ft.

WELL WATER TO BE USED AS: 5 Public water supply 8 Air conditioning 11 Injection well

1 Domestic 3 Feedlot 6 Oil field water supply 9 Dewatering 12 Other (Specify below)

2 Irrigation 4 Industrial 7 Lawn and garden only 10 Observation well

Was a chemical/bacteriological sample submitted to Department? Yes.....No..... If yes, mo/day/yr sample was submitted

Water Well Disinfected? Yes No

5 TYPE OF BLANK CASING USED:

1 Steel 3 RMP (SR)

2 PVC 4 ABS

5 Wrought iron

6 Asbestos-Cement

7 Fiberglass

8 Concrete tile

9 Other (specify below)

CASING JOINTS: Glued Clamped

Welded

Threaded

Blank casing diameter 1.6 in. to 41 ft., Dia. in. to ft., Dia. in. to ft.

Casing height above land surface 12 in. weight 32 lbs./ft. Wall thickness or gauge No. 1.88

TYPE OF SCREEN OR PERFORATION MATERIAL:

1 Steel 3 Stainless steel

2 Brass 4 Galvanized steel

5 Fiberglass

6 Concrete tile

7 Gauzed wrapped

8 Wire wrapped

9 PVC

10 Asbestos-cement

11 Other (specify)

12 None used (open hole)

N.A.

11 None (open hole)

SCREEN OR PERFORATION OPENINGS ARE:

1 Continuous slot 3 Mill slot

2 Louvered shutter 4 Key punched

5 Saw cut

6 Drilled holes

7 Torch cut

10 Other (specify)

SCREEN-PERFORATED INTERVALS: From ft. to ft., From ft. to ft., From ft. to ft.

From ft. to ft., From ft. to ft., From ft. to ft.

GRAVEL PACK INTERVALS: From ft. to ft., From ft. to ft., From ft. to ft.

From ft. to ft., From ft. to ft., From ft. to ft.

6 GROUT MATERIAL: 1 Neat cement 2 Cement grout 3 Bentonite 4 Other

Grout Intervals: From ft. to ft., From ft. to ft., From ft. to ft., From ft. to ft.

What is the nearest source of possible contamination:

1 Septic tank 4 Lateral lines

2 Sewer lines 5 Cess pool

3 Watertight sewer lines 6 Seepage pit

7 Pit privy

8 Sewage lagoon

9 Feedyard

10 Livestock pens

11 Fuel storage

12 Fertilizer storage

13 Insecticide storage

14 Abandoned water well

15 Oil well/Gas well

16 Other (specify below)

None

Direction from well?

FROM TO LITHOLOGIC LOG FROM TO LITHOLOGIC LOG

(Reconstruction)
 The well was constructed in 1928.
 Has a 6 ft dia pit - 17 ft depth.
 Going to extend the casing above
 ground surface & close the pit in.

7 CONTRACTOR'S OR LANDOWNER'S CERTIFICATION: This water well was (1) constructed (2) reconstructed, or plugged under my jurisdiction and was completed on (mo/day/year) 7-16-89 and this record is true to the best of my knowledge and belief. Kansas

Water Well Contractor's License No. 179 This Water Well Record was completed on (mo/day/yr) 7-14-89

under the business name of Joe's Well Service, Inc. Cimarron, KS by (signature) Judith Cisek

