

## WATER WELL RECORD

Form WWC-5

KSA 82a-1212

1 LOCATION OF WATER WELL:		Fraction NW $\frac{1}{4}$ SE $\frac{1}{4}$ NE $\frac{1}{4}$	Section Number 11	Township Number T 26 S	Range Number R 28 EW
---------------------------	--	--	----------------------	---------------------------	-------------------------

Distance and direction from nearest town or city street address of well if located within city?

210 East Ave. A, Cimarron, KS

2 WATER WELL OWNER: Grasser Oil Co.


RR#, St. Address, Box #: 210 East Ave. A

Board of Agriculture, Division of Water Resources

City, State, ZIP Code: Cimarron, Kansas 67335

Application Number:

3 LOCATE WELL'S LOCATION WITH AN "X" IN SECTION BOX:

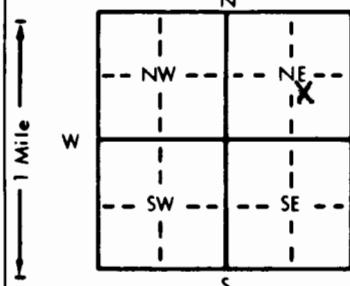

4 DEPTH OF COMPLETED WELL . . . . . 55 ft. ELEVATION: . . . . .

Depth(s) Groundwater Encountered 1 . . . . . 38 ft. 2 . . . . . ft. 3 . . . . . ft.

WELL'S STATIC WATER LEVEL . . . . . 37.2 ft. below land surface measured on mo/day/yr 12-3-93

Pump test data: Well water was . . . . . ft. after . . . . . hours pumping . . . . . gpm

Est. Yield . . . . . gpm: Well water was . . . . . ft. after . . . . . hours pumping . . . . . gpm

Bore Hole Diameter . . . . . 7.5 in. to . . . . . 55 ft. and . . . . . in. to . . . . . ft.

WELL WATER TO BE USED AS: 5 Public water supply 8 Air conditioning 11 Injection well

1 Domestic 3 Feedlot 6 Oil field water supply 9 Dewatering 12 Other (Specify below)

2 Irrigation 4 Industrial 7 Lawn and garden only 10 Monitoring well MW-10

Was a chemical/bacteriological sample submitted to Department? Yes . . . . . No X; If yes, mo/day/yr sample was submitted

Water Well Disinfected? Yes No 

5 TYPE OF BLANK CASING USED: 5 Wrought iron 8 Concrete tile CASING JOINTS: Glued . . . . . Clamped . . . . .

1 Steel 3 RMP (SR) 6 Asbestos-Cement 9 Other (specify below) Welded . . . . .

2 PVC 4 ABS 7 Fiberglass Threaded . . . . . X

Blank casing diameter . . . . . 2 in. to . . . . . 30 ft., Dia . . . . . in. to . . . . . ft., Dia . . . . . in. to . . . . . ft.

Casing height above land surface . . . . . 0.0 in., weight . . . . . lbs./ft. Wall thickness or gauge No. Schedule 40

TYPE OF SCREEN OR PERFORATION MATERIAL:

7 PVC

10 Asbestos-cement

1 Steel 3 Stainless steel 5 Fiberglass 8 RMP (SR) 11 Other (specify) . . . . .

2 Brass 4 Galvanized steel 6 Concrete tile 9 ABS 12 None used (open hole) . . . . .

SCREEN OR PERFORATION OPENINGS ARE: 5 Gauzed wrapped 8 Saw cut 11 None (open hole)

6 Wire wrapped

9 Drilled holes

1 Continuous slot 3 Mill slot 7 Torch cut 10 Other (specify) . . . . .

2 Louvered shutter 4 Key punched . . . . .

SCREEN-PERFORATED INTERVALS: From . . . . . 50 ft. to . . . . . 30 ft., From . . . . . ft. to . . . . . ft.

From . . . . . ft. to . . . . . ft., From . . . . . ft. to . . . . . ft.

GRAVEL PACK INTERVALS: From . . . . . 50 ft. to . . . . . 28 ft., From . . . . . ft. to . . . . . ft.

From . . . . . ft. to . . . . . ft., From . . . . . ft. to . . . . . ft.

6 GROUT MATERIAL: 1 Neat cement 2 Cement grout 3 Bentonite 4 Other . . . . .

Grout Intervals: From . . . . . 28 ft. to . . . . . 25.5 ft., From . . . . . 25.5 ft. to . . . . . 0 ft., From . . . . . ft. to . . . . . ft.

What is the nearest source of possible contamination: 10 Livestock pens 14 Abandoned water well

1 Septic tank 4 Lateral lines 7 Pit privy 11 Fuel storage 15 Oil well/Gas well

2 Sewer lines 5 Cess pool 8 Sewage lagoon 12 Fertilizer storage 16 Other (specify below)

3 Watertight sewer lines 6 Seepage pit 9 Feedyard . . . . .

13 Insecticide storage . . . . .

How many feet?

Direction from well?

FROM TO LITHOLOGIC LOG FROM TO PLUGGING INTERVALS

0 5 Clay, light brown plastic . . . . .

5 10 Clay light brown plastic . . . . .

10 15 Clay light brown plastic . . . . .

15 20 Clay medium brown slightly silty . . . . .

20 25 clay medium brown slightly silty . . . . .

25 30 Clay medium brown slightly silty . . . . .

30 35 Clay brown slightly silty to sandy . . . . .

35 40 Sand medium to fine grained unconsolidated . . . . .

40 45 Sand, medium to large grained, unconsolidated, gravel small to large, saturated . . . . .

45 50 Sand, medium to large grained, unconsolidated, gravel small to large, saturated . . . . .

Flush Mount approved by

Don Taylor (10-14-93)

KDHE Project Code #01035354

7 CONTRACTOR'S OR LANDOWNER'S CERTIFICATION: This water well was 1 constructed, (2) reconstructed, or (3) plugged under my jurisdiction and was completed on (mo/day/year) 11-15-93 and this record is true to the best of my knowledge and belief. Kansas

Water Well Contractor's License No. 540 This Water Well Record was completed on (mo/day/yr) 12/15/93 under the business name of Prairie Land Environmental Remediation, Inc. (signature) 1/16/94

INSTRUCTIONS: Use typewriter or ball point pen. PLEASE PRESS FIRMLY and PRINT clearly. Please fill in blanks, underline or circle the correct answers. Send top three copies to Kansas Department of Health and Environment, Bureau of Water, Topeka, Kansas 66620-0001. Telephone: 913-296-5545. Send one to WATER WELL OWNER and retain one for your records.