

1 LOCATION OF WATER WELL:		Fraction NE $\frac{1}{4}$ NW $\frac{1}{4}$ NE $\frac{1}{4}$	Section Number 11	Township Number T 26 S	Range Number R 28 E <input checked="" type="checkbox"/>
---------------------------	--	--	----------------------	---------------------------	--

Distance and direction from nearest town or city street address of well if located within city?

202 N. Main, Cimarron, Kansas

2 WATER WELL OWNER: Grain Growers Cooperative


RR#, St. Address, Box # : 202 N. Main, Box 508

Board of Agriculture, Division of Water Resources

City, State, ZIP Code : Cimarron, KS 67835

Application Number:

3 LOCATE WELL'S LOCATION WITH AN "X" IN SECTION BOX:

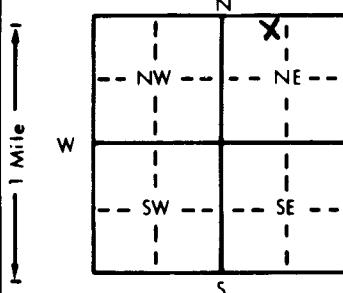

4 DEPTH OF COMPLETED WELL .75 ft. ELEVATION:

Depth(s) Groundwater Encountered 1. 53 ft. 2. ft. 3. ft.

WELL'S STATIC WATER LEVEL .51.5 ft. below land surface measured on mo/day/yr 12-3-93

Pump test data: Well water was ft. after hours pumping gpm

Est. Yield gpm: Well water was ft. after hours pumping gpm

Bore Hole Diameter .10.25.in. to .78 ft., and in. to ft.

WELL WATER TO BE USED AS: 5 Public water supply 8 Air conditioning 11 Injection well

1 Domestic 3 Feedlot 6 Oil field water supply 9 Dewatering 12 Other (Specify below)

2 Irrigation 4 Industrial 7 Lawn and garden only 10 Monitoring well PPW-1

Was a chemical/bacteriological sample submitted to Department? Yes No X; If yes, mo/day/yr sample was submitted

Water Well Disinfected? Yes No X

5 TYPE OF BLANK CASING USED:

1 Steel 3 RMP (SR) 5 Wrought iron 8 Concrete tile CASING JOINTS: Glued Clamped

2 PVC 4 ABS 6 Asbestos-Cement 9 Other (specify below) Welded

3 PVC 4 ABS 7 Fiberglass Threaded

Blank casing diameter .5 in. to .45 ft., Dia in. to ft., Dia in. to ft.

Casing height above land surface in., weight lbs./ft. Wall thickness or gauge No. Schd. 40

TYPE OF SCREEN OR PERFORATION MATERIAL:

1 Steel 3 Stainless steel 5 Fiberglass 8 RMP (SR) 10 Asbestos-cement

2 Brass 4 Galvanized steel 6 Concrete tile 9 ABS 11 Other (specify)

7 PVC 12 None used (open hole)

SCREEN OR PERFORATION OPENINGS ARE:

1 Continuous slot 3 Mill slot 5 Gauzed wrapped 8 Saw cut 11 None (open hole)

2 Louvered shutter 4 Key punched 6 Wire wrapped 9 Drilled holes 10 Other (specify)

SCREEN-PERFORATED INTERVALS: From 75 ft. to .45 ft., From ft. to ft.

From ft. to ft., From ft. to ft.

GRAVEL PACK INTERVALS: From 75 ft. to .42 ft., From ft. to ft.

From ft. to ft., From ft. to ft.

6 GROUT MATERIAL: 1 Neat cement 2 Cement grout 3 Bentonite 4 Other

Grout Intervals: From 42 ft. to .39 ft., From 39 ft. to 0.0 ft., From ft. to ft.

What is the nearest source of possible contamination:

1 Septic tank 4 Lateral lines 7 Pit privy 10 Livestock pens 14 Abandoned water well


2 Sewer lines 5 Cess pool 8 Sewage lagoon 11 Fuel storage 15 Oil well/Gas well

3 Watertight sewer lines 6 Seepage pit 9 Feedyard 12 Fertilizer storage 16 Other (specify below)

Direction from well?

FROM	TO	LITHOLOGIC LOG	FROM	TO	PLUGGING INTERVALS
0	5	Clay brown, slightly silty, slightly moist, with			small amount of sand
5	10	Clay medium brown slightly silty to malible with			small amount of sand
10	15	Clay medium brown, slightly silty to malible with small amount of sand, slight odor			
15	20	Clay dark brown, slightly silty to malible with small amount of sand slight odor			
20	25	Clay dark brown, slighly silty to malible, with			small amount of sand, medium odor
25	30	Clay dark brown, slightly silty to malible, with			small amount of sand, slight odor
30	35	Clay dark brown, slightly moist, slightly plastic with			small amount of caliche-white
		strong odor			
35	40	Clay dark brown, slighly moist, slightly plastic with			small amount of caliche-white
		strong odor			
40	45	Clay light brownish gray, very plastic very moist			
45	50	Clay brownish gray very wet with very fine grain			sand, well sorted, very strong odor

7 CONTRACTOR'S OR LANDOWNER'S CERTIFICATION: This water well was (1) constructed, (2) reconstructed, or (3) plugged under my jurisdiction and was completed on (mo/day/year) 11-30-93 and this record is true to the best of my knowledge and belief. Kansas

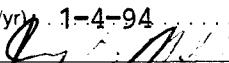Water Well Contractor's License No. 540 This Water Well Record was completed on (mo/day/yr) 1-4-94 under the business name of Prairie Land Environmental Remediation, Inc. 

INSTRUCTIONS: Use typewriter or ball point pen. PLEASE PRESS FIRMLY and PRINT clearly. Please fill in blanks, underline or circle the correct answers. Send top three copies to Kansas Department of Health and Environment, Bureau of Water, Topeka, Kansas 66202-0001. Telephone: 913-296-5545. Send one to WATER WELL OWNER and retain one for your records.