

WATER WELL RECORD

Form WWC-5 KSA 82a-1212

1 LOCATION OF WATER WELL:

Fraction

NW 1/4

SE 1/4

Section Number

11

Township Number

T 26

S

Range Number

R 28

E/W

Distance and direction from nearest town or city street address of well if located within city?

210 East Avenue A, Cimarron, Kansas

2 WATER WELL OWNER: Grasser Oil Co.


RR#, St. Address, Box #: 210 East Avenue A

Board of Agriculture, Division of Water Resources

City, State, ZIP Code: Cimarron, KS 67835

Application Number:

3 LOCATE WELL'S LOCATION WITH AN "X" IN SECTION BOX:

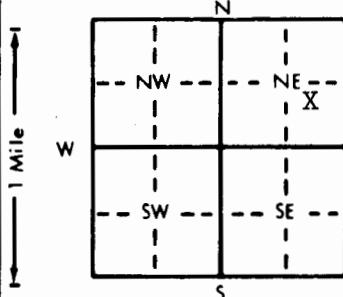

4 DEPTH OF COMPLETED WELL 47 ft. ELEVATION: 197.61

Depth(s) Groundwater Encountered 1 162.64 ft. 2 ft. 3 ft.

WELL'S STATIC WATER LEVEL 40.5 ft. below land surface measured on mo/day/yr 9/23/92

Pump test data: Well water was ft. after hours pumping gpm

Est. Yield gpm: Well water was ft. after hours pumping gpm

Bore Hole Diameter 6.5/8 in. to 47 ft., and in. to ft.

WELL WATER TO BE USED AS: 5 Public water supply 8 Air conditioning 11 Injection well

1 Domestic 3 Feedlot 6 Oil field water supply 9 Dewatering 12 Other (Specify below)

2 Irrigation 4 Industrial 7 Lawn and garden only 10 Monitoring well MW-6

Was a chemical/bacteriological sample submitted to Department? Yes No X If yes, mo/day/yr sample was submitted

Water Well Disinfected? Yes No X

5 TYPE OF BLANK CASING USED:

1 Steel 3 RMP (SR)
2 PVC 4 ABS

5 Wrought iron 8 Concrete tile CASING JOINTS: Glued Clamped

6 Asbestos-Cement 9 Other (specify below) Welded

7 Fiberglass Threaded

Blank casing diameter 2 in. to 27 ft., Dia in. to ft., Dia in. to ft.

Casing height above land surface 0.0 in., weight lbs./ft. Wall thickness or gauge No. Sched. 40

TYPE OF SCREEN OR PERFORATION MATERIAL:

1 Steel 3 Stainless steel 5 Fiberglass 8 RMP (SR) 10 Asbestos-cement

2 Brass 4 Galvanized steel 6 Concrete tile 9 ABS 11 Other (specify)

7 PVC 12 None used (open hole)

SCREEN OR PERFORATION OPENINGS ARE:

1 Continuous slot 3 Mill slot 5 Gauzed wrapped 8 Saw cut 11 None (open hole)

2 Louvered shutter 4 Key punched 6 Wire wrapped 9 Drilled holes

7 Torch cut 27.0 10 Other (specify)

SCREEN-PERFORATED INTERVALS: From ft. to ft., From ft. to ft.

From ft. to ft., From ft. to ft.

GRAVEL PACK INTERVALS: From 47.0 ft. to 24.5 ft., From ft. to ft.

From ft. to ft., From ft. to ft.

6 GROUT MATERIAL: 1 Neat cement 2 Cement grout 3 Bentonite 4 Other

Grout Intervals: From 24.5 ft. to 22.0 ft., From 22.0 ft. to ft., From ft. to ft.

What is the nearest source of possible contamination: 10 Livestock pens 14 Abandoned water well

1 Septic tank 4 Lateral lines 7 Pit privy 11 Fuel storage 15 Oil well/Gas well

2 Sewer lines 5 Cess pool 8 Sewage lagoon 12 Fertilizer storage 16 Other (specify below)

3 Watertight sewer lines 6 Seepage pit 9 Feedyard

13 Insecticide storage

How many feet?

Direction from well?

FROM	TO	LITHOLOGIC LOG	FROM	TO	PLUGGING INTERVALS
0	5	Clay, Med. Brn., Silty, Lean			
5	10	Clay, Med.-Lt. Brn., Silty, Lean			
10	15	Clay, Med.-Lt. Brn., Silty, Lean			
15	20	Clay, Med. Brn., Silty, Lean			
20	25	Clay, Med. Dk. Brn., Silty, Lean			
25	30	Clay, Dk.-Med. Gray, S1. Silty, Lean			
30	35	Sand, Tan-Med. Gray, C-M Gr.			
35	40	Gravel, Brn.-Tan, Med. to Coarse			
40	47	Sand, C-Med. Gr., Some Fine			